3130

.DELL COUNTY HEALTH DEPARTMENT

STATESVILLE 704-878-5305 (D) MOORESVILLE 704-664-5281

IMPROVEMENT PERMIT / AUTHORIZATION TO CONSTRUCT / OPERATION PERMIT / EXISTING SYSTEM INSPECTION

PERMIT# 103051 PIN# 4636 97 5125 DATE 11/14/01

OWNER OR CONTRACTOR Teyland - Brown Const. PHONE: Business 895-9652 Home

ADDRESS 7502 Windalier Cornelius, NC. 28031

LOCATION 1100 Ft Conversback Ft Turnberry Ln. Lot on (L)

SUBDIVISION St Andrews Village BLOCK / SECTION LOT 6 LOT AREA .5AC SITE CLASS. PS DESIGN FLOW 360 L.T.A.R. .3

Septic Tank: 1000 Gallons; STB 1012 Date 10-21-01
Pump Tank: Gallons; PT Date
Pump Make: Model Serial No.
Nitrification Field: No Fields 1 Square Feet 900* Linear Feet 300*
No Lines 3@100' Trench Width 3' Max Trench Bottom Depth 3' Gravel Depth No

[X] New System [ ] Repair System Type: I, II, (III), IV, V, VI
System Description: ERAY - EZFLOW 6CH. PLASTIC
Repair System Description: None
Maintenance Agreement Required: [ ] Yes [X] No

[X] House/Mod. Home No. Bedrooms 3
[ ] Mobile Home No. Bathrooms 3
[ ] Business No. Employees
[ ] Other


[ ] Slab [X] Crawl Space [ ] Basement w/plumbing [ ] Basement wo/plumbing

Water Supply: [ ] Individual [ ] Public [X] Community

Comments/Conditions: * 25% reduced system *

Comments/Conditions: Installed Plastic Chambers Polylok filter. Used distribution box instead of "drop boxes"

INITIAL SITE SKETCH

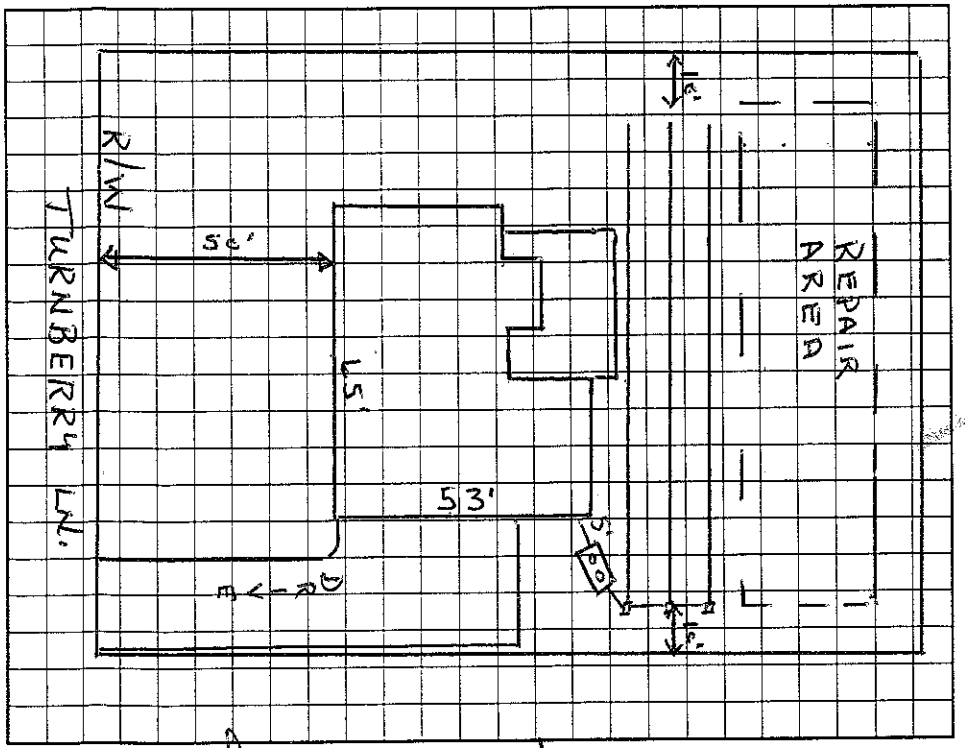

AS BUILT SKETCH

Installed as drawn

Permit can be suspended or revoked if any false information is supplied toward securing the permit/any unauthorized changes are made to the site/any unauthorized changes are made in the installation of the system. Improvement Permit with plat valid without expiration. Improvement Permit with site plan valid for sixty months. Authorization to Construct is valid for a period equal to that of Improvement Permit – not to exceed sixty months.

Signed: * date 11-15-01 Installed by: Richard Abernathy

Improvement Permit by: Wesley Sparks RS. date 11/14/01 Operation Permit by: Maria H. Dolan RS date 11/24/2002

Authorization to Construct by: Wesley Sparks RS. date 11/14/01 Existing System Inspection by: date

HEALTH DEPT. COPY: WHITE OWNER COPY (FINAL): YELLOW OWNER COPY (INITIAL): PINK