# IREDELL COUNTY HEALTH DEPARTMENT

STATESVILLE 704-878-5305 MOORESVILLE 704-664-5281

## IMPROVEMENT PERMIT / AUTHORIZATION TO CONSTRUCT / OPERATION PERMIT / EXISTING SYSTEM INSPECTION

(300)

PERMIT# 79548 PIN# ~~4653975660~~ 4644-17-6011 DATE 3/12/99

OWNER OR CONTRACTOR JACK WEST PHONE: Business Home

ADDRESS 721 ISLE OF PINES RD - MOORESVILLE NC 28117

LOCATION BRAWLEY SCHOOL - TL CANVASBACK - TL WOODDUCK - 10TH ON RT

SUBDIVISION LAKESIDE PARK BLOCK / SECTION LOT 25 LOT AREA .94AC SITE CLASS. PS DESIGN FLOW 360 L.T.A.R. .3

Septic Tank: 1000 Gallons; STB 825 Date 11/1/99
Pump Tank: Gallons; PT Date
Pump Make: Model Serial No.
Nitrification Field: No Fields 1 Square Feet 900 Linear Feet 300
No Lines 5@60' Trench Width 36" Max Trench Bottom Depth 36" Gravel Depth N/A

~~New System~~ ☐ Repair System Type: I, II, III, IV, V, VI
System Description: GRAVITY CHAMBERS OR EQ
Repair System Description: PUMP PANEL
Maintenance Agreement Required: ☐ Yes ☒ No


~~House/Mod. Home~~ No. Bedrooms 3
☐ Mobile Home No. Bathrooms 2
☐ Business No. Employees
☐ Other
☐ Slab ☑ Crawl Space ☐ Basement w/plumbing ☐ Basement wo/plumbing

Water Supply:
☐ Individual
☐ Public
~~☐ Community~~

Comments:/Conditions:

Comments:/Conditions:

INITIAL SITE SKETCH 1"=40'

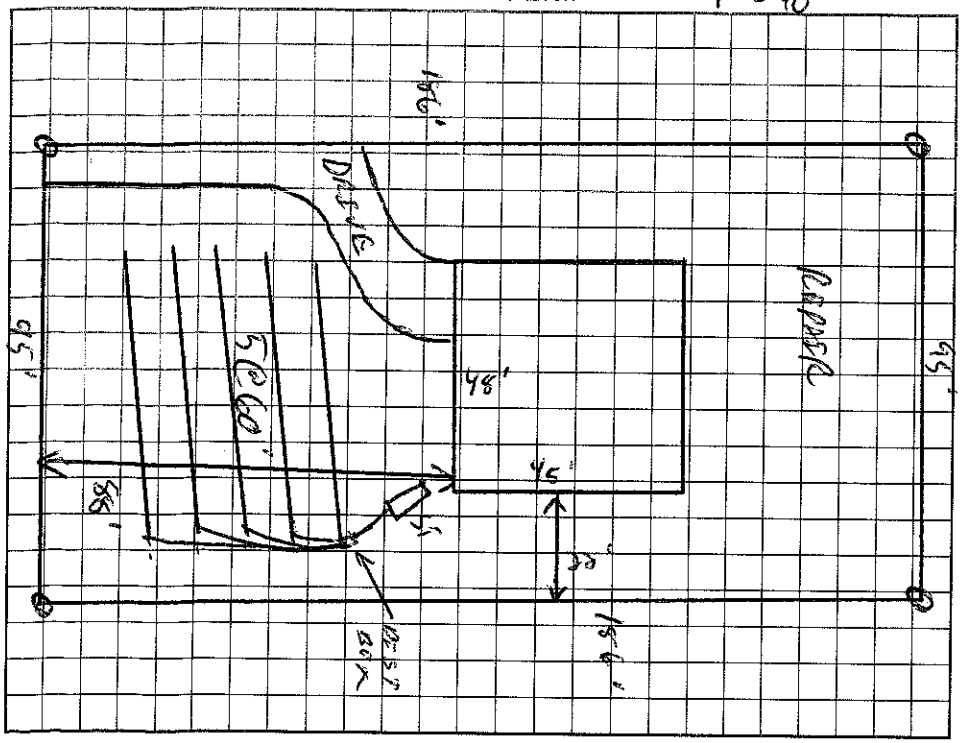


AS BUILT SKETCH

Permit can be suspended or revoked if any false information is supplied toward securing the permit/any unauthorized changes are made to the site/any unauthorized changes are made in the installation of the system. Improvement Permit with plat valid without expiration. Improvement Permit ~~with site~~ plan valid for sixty months. Authorization to Construct is valid for a period equal to that of Improvement Permit – not to exceed sixty months.

Signed: R Stamps date 3/18/99 Installed by: WAYNE CLONTZ

Improvement Permit by: C. Hyatt MS date 3/18/99 Operation Permit by: C. Hyatt MS date 1/6/00

Authorization to Construct by: C. Hyatt MS date 3/22/99 Existing System Inspection by: date

HEALTH DEPT. COPY: WHITE OWNER COPY (FINAL): YELLOW OWNER COPY (INITIAL): PINK