IREDELL COUNTY HEALTH DEPARTMENT

STATESVILLE 704-878-5305 MOORESVILLE 704-664-5281

IMPROVEMENT PERMIT / AUTHORIZATION TO CONSTRUCT / OPERATION PERMIT / EXISTING SYSTEM INSPECTION

PERMIT# 12172 PIN# 4636-97-5888 DATE 1/10/05

OWNER OR CONTRACTOR Ryon-West Development PHONE: Business Home

ADDRESS 127-B Promenade Dr. Mooresville, NC 28117

LOCATION BSR, TL Canvasback, TL 1st Woodduck Lp on Lt

SUBDIVISION Lakeside Farm BLOCK / SECTION LOT 8 LOT AREA 0.54± ac SITE CLASS PS DESIGN FLOW 480 L.T.A.R. 0.3

Septic Tank: 1000 Gallons; STB 1007 Date 9/6/04

Pump Tank: Gallons; PT Date

Pump Make: Model Serial No.

Nitrification Field: No Fields 1 Square Feet 840 Linear Feet 280'

No Lines 8 @ 35' Trench Width 36" Max Trench Bottom Depth 36" Gravel Depth —

☒ New System ☐ Repair System Type: I, II, (III), IV, V, VI

System Description: Gravity Conv. LPP Sand Block

Repair System Description:

Maintenance Agreement Required: ☐ Yes ☒ No

☒ House/Mod. Home No. Bedrooms 4

☐ Mobile Home No. Bathrooms

☐ Business No. Employees

☐ Other

☐ Slab ☐ Crawl Space ☒ Basement w/plumbing ☐ Basement wo/plumbing


Water Supply: ☐ Individual ☐ Public ☒ Community

Comments:/Conditions:

1" = 40'

Comments:/Conditions:

INITIAL SITE SKETCH

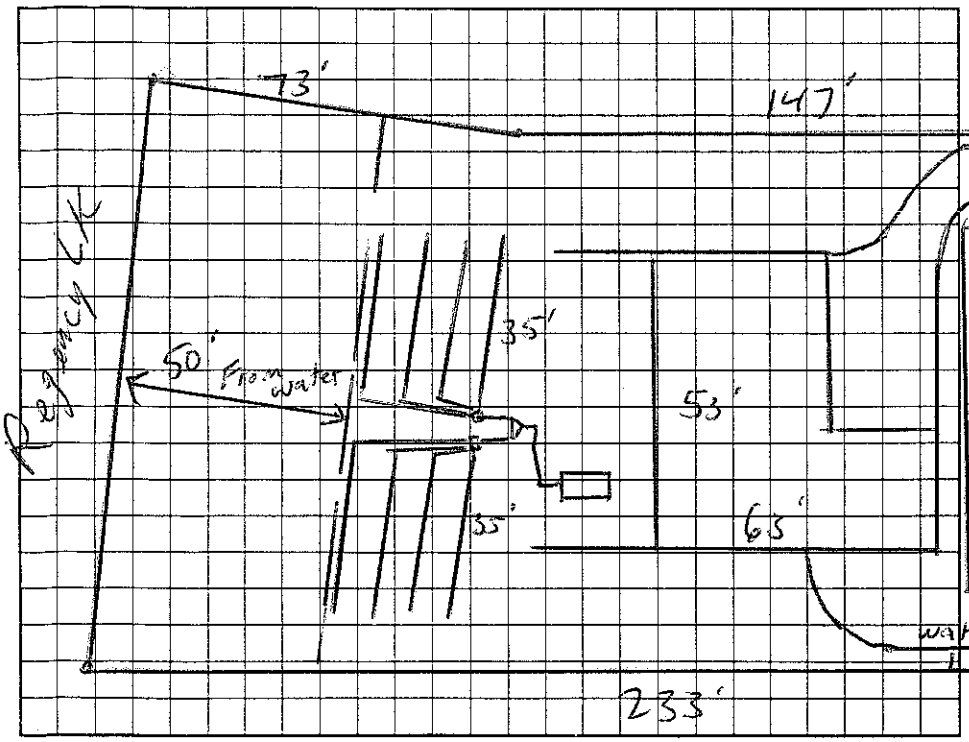

AS BUILT SKETCH

Permit can be suspended or revoked if any false information is supplied toward securing the permit/any unauthorized changes are made to the site/any unauthorized changes are made in the installation of the system. Improvement Permit with plat valid without expiration. Improvement Permit with site plan valid for sixty months. Authorization to Construct is valid for a period equal to that of Improvement Permit – not to exceed sixty months.

Signed: date 1/11/05 Installed by: Wayne Clontz

Improvement Permit by: RS date 1/10/05 Operation Permit by: RS date 1/27/05

Authorization to Construct by: RS date 1/10/05 Existing System Inspection by: date

HEALTH DEPT. COPY: WHITE OWNER COPY (FINAL): YELLOW OWNER COPY (INITIAL): PINK