IREDELL COUNTY HEALTH DEPARTMENT

STATESVILLE 704-878-5305 MOORESVILLE 704-664-5281

IMPROVEMENT PERMIT / AUTHORIZATION TO CONSTRUCT / OPERATION PERMIT / EXISTING SYSTEM INSPECTION

PERMIT# 073583 PIN# 4636 97 78 17 DATE 7/21/98

OWNER OR CONTRACTOR Douglas Payne PHONE: Business 896-3309 Home (704) 873-2654

ADDRESS 163 Bost St. Statesville, NC 28677

LOCATION Brawley School Rd TL Canvasback TL Wood Duck ON left 7th lot

SUBDIVISION Lakeside Farm BLOCK / SECTION ____ LOT 9 LOT AREA ____ SITE CLASS. PS DESIGN FLOW 360gpd L.T.A.R. .37

Septic Tank: 1000 Gallons; STB 794 Date 11/6/97

Pump Tank: 1000 Gallons; PT 27 Date 11/6/97

Pump Make: MYERS Model ME3F-11 Serial No. 8/99

Nitrification Field: No Fields 1 Square Feet 900* Linear Feet 300*

No Lines 4 at 75' Trench Width 36" Max Trench Bottom Depth 36"

☒ New System ☐ Repair System Type: I, II, (III), IV, V, VI

System Description: Pump(PM) - 25% Reduction

Repair System Description: Pump to Modified

Maintenance Agreement Required: ☐ Yes ☐ No

Gravel Depth N/A

☒ House/Mod. Home ☐ Mobile Home ☐ Business ☐ Other Partial

No. Bedrooms 3* No. Bathrooms 2.5 No. Employees ____


☐ Slab ☐ Crawl Space ☒ Basement w/plumbing ☐ Basement wo/plumbing

Water Supply: ☐ Individual ☐ Public ☒ Community


Comments:/Conditions: * 25% Reduction in Drainfield Area
Keep Septic System at least 5' from House & 10' from PL.

Comments:/Conditions: * 3 Bedrooms + Bonus Room
Partial (1/2 Basement)

INITIAL SITE SKETCH Scale 1:50

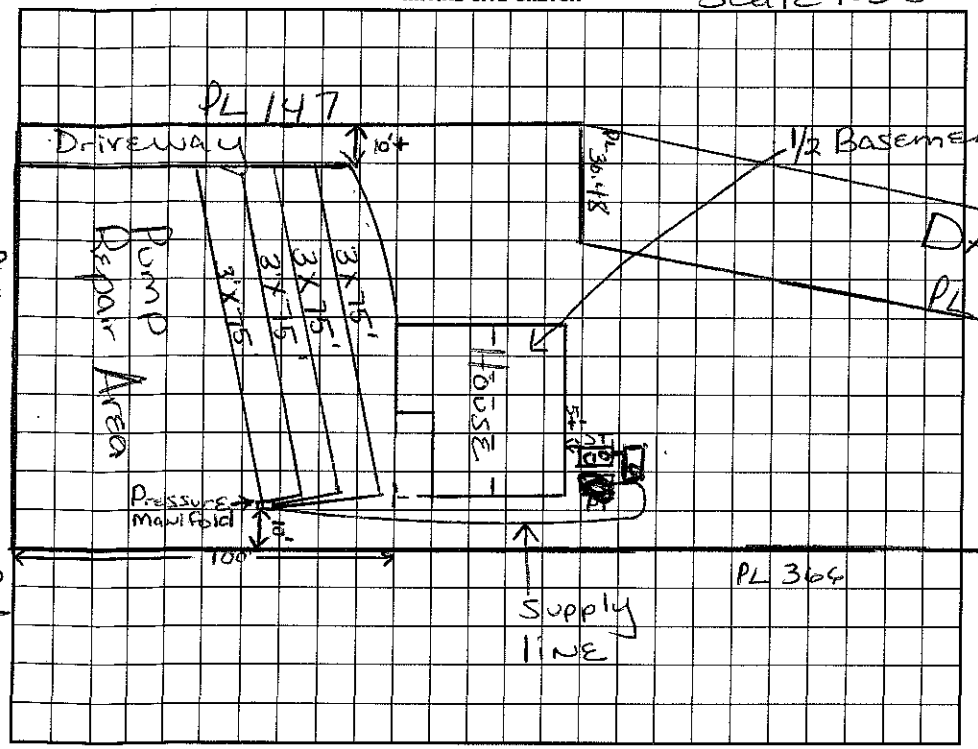

AS BUILT SKETCH

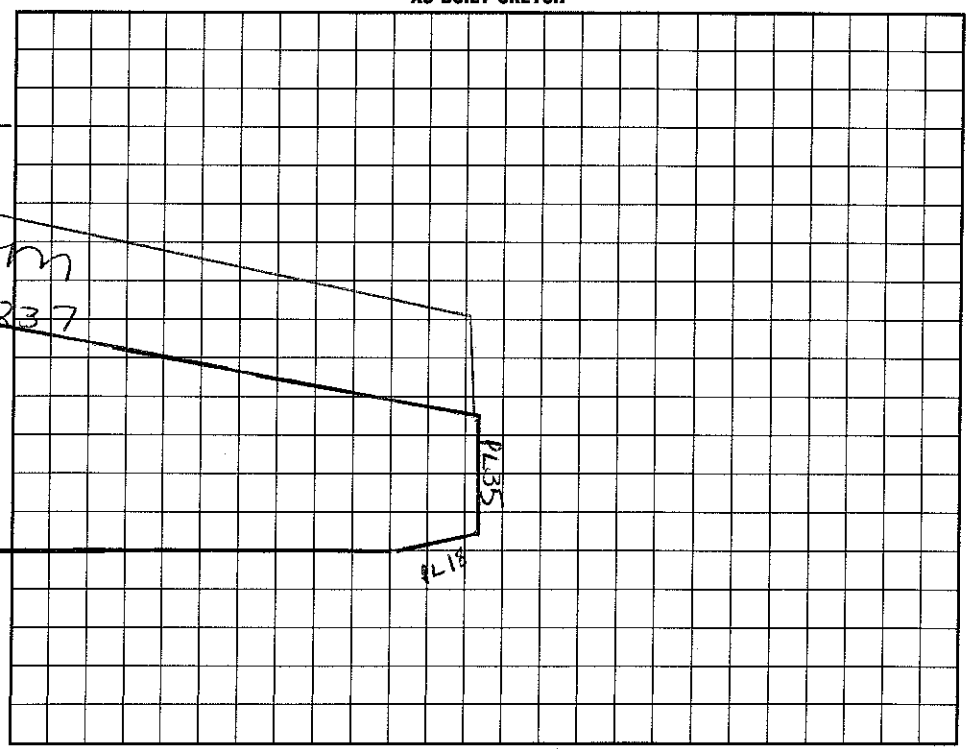

I understand that this permit can be suspended or revoked if any false information is supplied toward securing the permit/any unauthorized changes are made to the site/any unauthorized changes are made in the installation of the system. Improvement Permit with plat valid without expiration. Improvement Permit with site plan valid for sixty months. Authorization to Construct is valid for a period equal to that of Improvement Permit – not to exceed sixty months.

Signed: _____ date 8/31/98 Installed by: Bob Mayhew

Improvement Permit by: Marian H. H. Dotson date 7/16/98 Operation Permit by: Wesley Sparks RS. date 3/2/00

Authorization to Construct by: Marian H. H. Dotson date 7/16/98 Existing System Inspection by: _____ date _____

HEALTH DEPT. COPY: WHITE INSPECTION COPY (FINAL): GREEN OWNER COPY (FINAL): YELLOW INSPECTION COPY (INITIAL): PINK OWNER COPY (INITIAL): GOLD