IREDELL COUNTY HEALTH DEPARTMENT

Authorization to Construct

3rd

ATESVILLE 704-878-5305 MOORESVILLE 704-664-5281

IMPROVEMENT PERMIT / ~~CERTIFICATE OF COMPLETION~~ / OPERATION PERMIT / EXISTING SYSTEM INSPECTION

PROPERTY DESCRIPTION NO. 2283.9 DATE 1/11/96 TAX MAP NO. 2K 11 A 10 Watershed: X Yes ☐ No

OWNER OR CONTRACTOR Keith Waldo PHONE: Business 4636 97 7891 Home 896-4686

ADDRESS 252 Timberland Lp, Mooresville, NC.

LOCATION 1100 TL Conover back TL 1st Woodruck Lp to 10th lot on (L)

SUBDIVISION Lakeside Farm BLOCK / SECTION LOT 10 LOT AREA .82 SITE CLASS. PS DESIGN FLOW 480 L.T.A.R. .3

Septic Tank: 1000 Gallons; STB 794 Date ~~4/16/97~~ 2/10/97

Pump Tank: 1000 Gallons; PT 27 Date

Pump Make: Deutz Model ~~EC-2111-12~~ Serial No. ~~G5EC1300~~

Nitrification Field: No Fields 1 Square Feet 1600 Linear Feet 400 (533)

No Lines 5 Trench Width 36" Max Trench Bottom Depth 36 Gravel Depth Sand

X New System ☐ Repair System Type: I. II. (III) IV. V. VI

System Description: Pres Manifold - shallow trench

Repair System Description: None

Maintenance Agreement Required: X Yes ☐ No SYR

X House/Mod. Home No. Bedrooms 4

☐ Mobile Home No. Bathrooms 2.5

☐ Business No. Employees

☐ Other

☐ Slab ☐ Crawl Space X Basement w/plumbing ☐ Basement wo/plumbing


Water Supply: ☐ Individual X Community ☐ Public

Comments: X 25% reduction for shallow trench use (1) 4" ID SCH 80 PVC Pressure Manifold - 2' TOH Manifold Pressure - 5 1/2" taps on 6" Centers - Opposite side of manifold for Repair/Addition Drainfield


Comments:

WE0311M = 973621

INITIAL SITE SKETCH

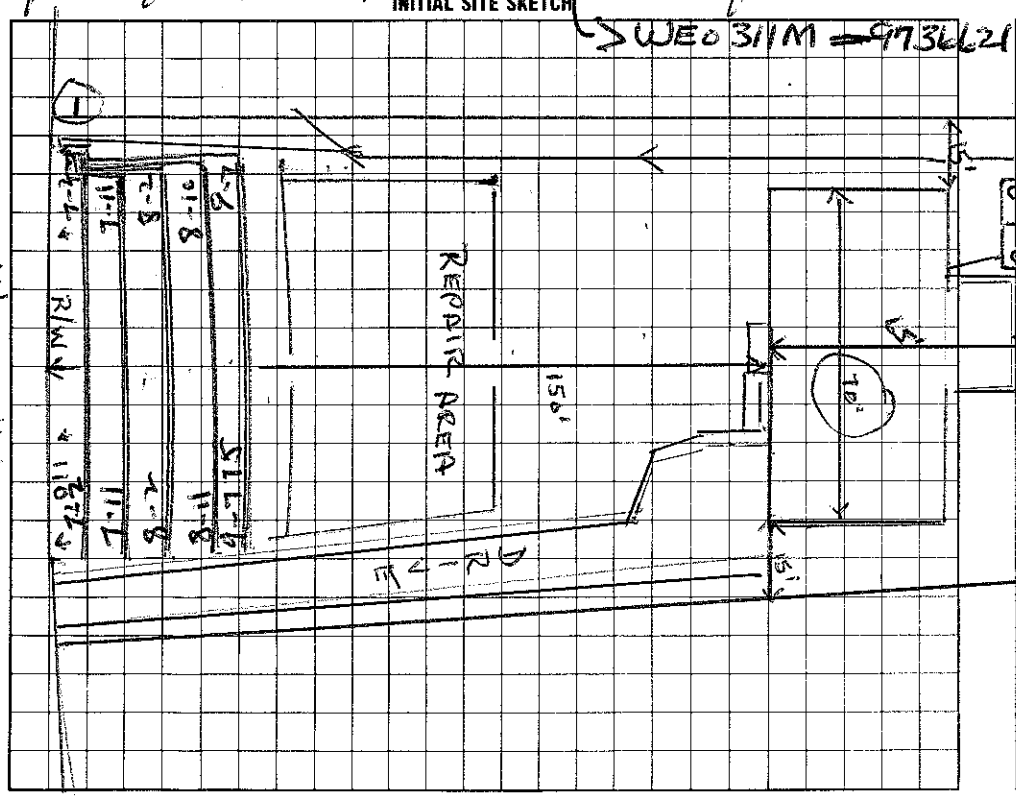

AS BUILT SKETCH

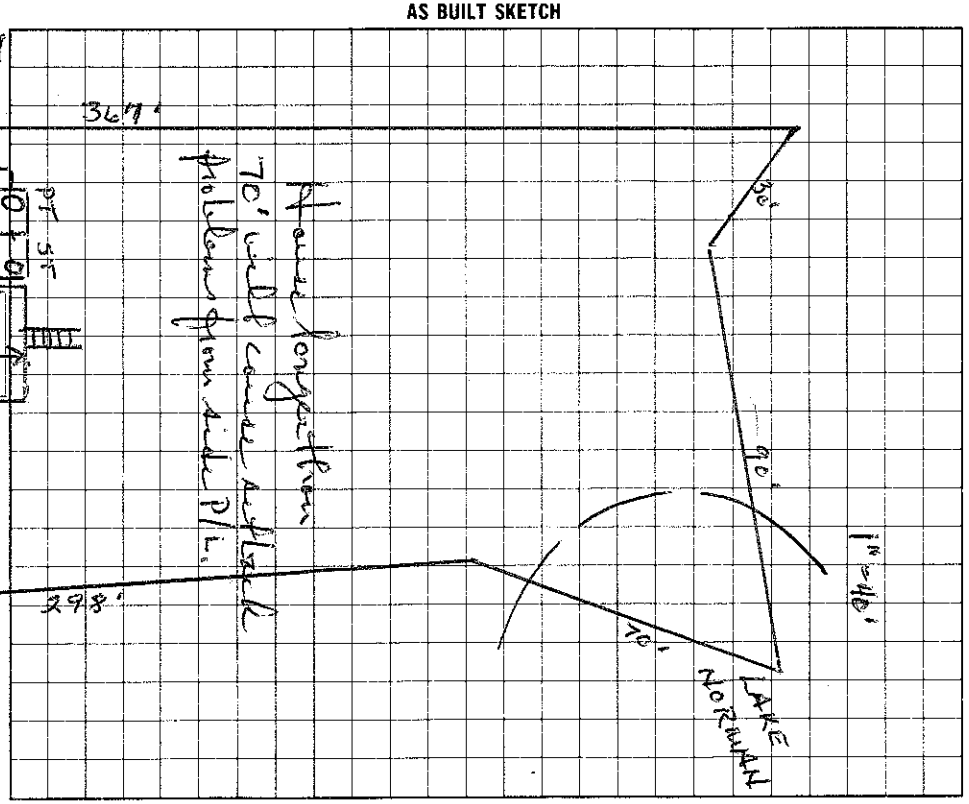

I understand that this permit can be suspended or revoked if any false information is supplied toward securing the permit/any unauthorized changes are made to the site/any unauthorized changes are made in the installation of the system.

Signed: Dina Waldo

Improvement Permit by: Wesley Sparks RS. date 1/11/96

~~Existing System Inspection by~~ Authorization to Construct Wesley Sparks RS. date 1/11/96

Installed by: Curt Dunnick

Certificate of Completion by: Wesley Sparks RS date 4/24/97

Operation Permit by: Wesley Sparks RS date 4/24/97

HEALTH DEPT. COPY: WHITE INSPECTION COPY (FINAL): GREEN OWNER COPY (FINAL): YELLOW INSPECTION COPY (INITIAL): PINK OWNER COPY (INITIAL): GOLD