IREDELL COUNTY HEALTH DEPARTMENT

STATESVILLE 704-878-5305 MOORESVILLE 704-664-5281

IMPROVEMENT PERMIT / AUTHORIZATION TO CONSTRUCT / OPERATION PERMIT / EXISTING SYSTEM INSPECTION

PERMIT# 081909 PIN# 4636978071 DATE 7/13/99

OWNER OR CONTRACTOR G. F. Allen PHONE: Business Home 704-660-1671

ADDRESS 131 Sundown, Mooresville, NC 28117

LOCATION B. Sch., Tl Canvasback, TL Turnberry, on LT

SUBDIVISION St. Andrews Vill BLOCK / SECTION LOT 9 LOT AREA .53 SITE CLASS. 05 DESIGN FLOW 480 L.T.A.R. .3

Septic Tank: 1000 Gallons; STB 1017 Date 8/27/99
Pump Tank: Gallons; PT Date
Pump Make: Model Serial No.
Nitrification Field: No Fields 1 Square Feet 1200 Linear Feet 400
No Lines 4@100 Trench Width 36" Max Trench Bottom Depth 36" Gravel Depth N/A

☒ New System ☐ Repair System Type: I, II, (III) IV, V, VI
System Description: Grav/ 25% Redx
Repair System Description: Level
Maintenance Agreement Required: ☐ Yes ☐ No


☒ House/Mod. Home No. Bedrooms 4
☐ Mobile Home No. Bathrooms 3
☐ Business No. Employees
☐ Other

☐ Slab ☒ Crawl Space ☐ Basement w/plumbing ☐ Basement wo/plumbing

Water Supply: ☐ Individual ☐ Public ☑ Community

Comments:/Conditions:

INITIAL SITE SKETCH

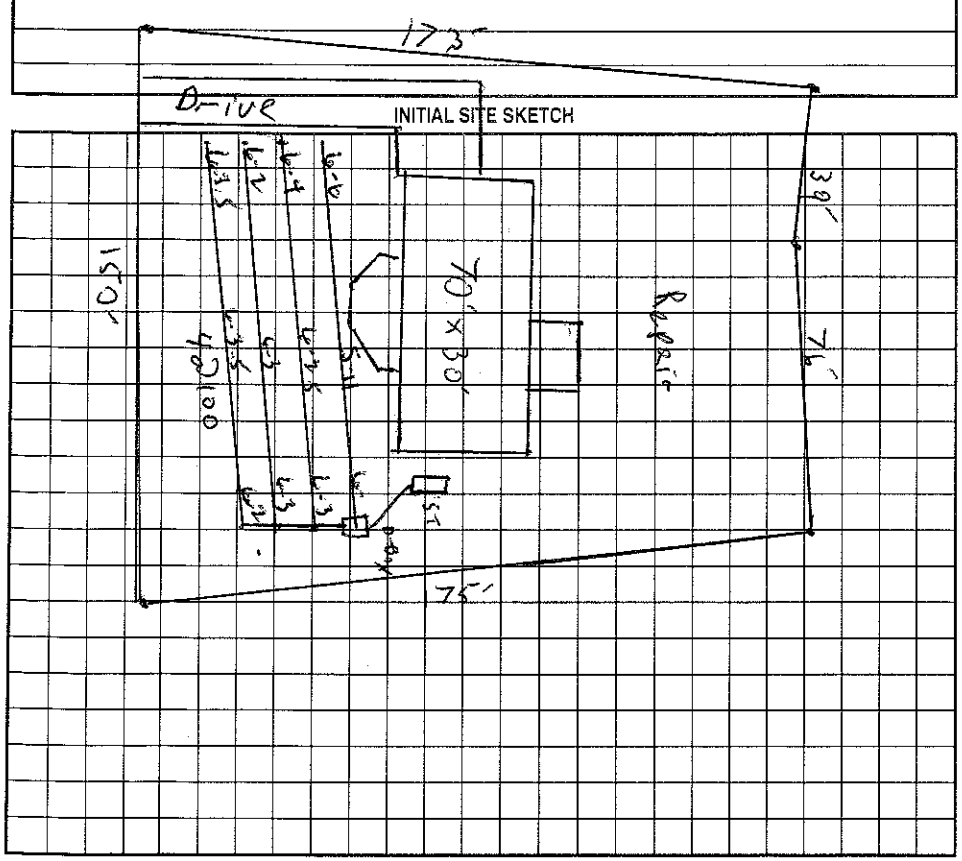

Comments:/Conditions:

8-24-99 Renewed house plan - appears in compliance w/IP
House to be located as shown - MRF

AS BUILT SKETCH

Permit can be suspended or revoked if any false information is supplied toward securing the permit/any unauthorized changes are made to the site/any unauthorized changes are made in the installation of the system. Improvement Permit with plat valid without expiration. Improvement Permit with site plan valid for sixty months. Authorization to Construct is valid for a period equal to that of Improvement Permit – not to exceed sixty months.

Signed: Mary L. Allen date 7/29/99 Installed by: Richard Abernathy

Improvement Permit by: Jeff Morrison date 7/13/99 Operation Permit by: Wesley Sparks R.S. date 12/3/99

Authorization to Construct by: Marvel B. Freeman, RS date 8-24-99 Existing System Inspection by: date

HEALTH DEPT. COPY: WHITE OWNER COPY (FINAL): YELLOW OWNER COPY (INITIAL): PINK