IREDELL COUNTY HEALTH DEPARTMENT

STATESVILLE 704-878-5305 / 125.00 Paid MOORESVILLE 704-664-5281

A

IMPROVEMENT PERMIT / AUTHORIZATION TO CONSTRUCT / OPERATION PERMIT / EXISTING SYSTEM INSPECTION

PERMIT# 93309 PIN# 4636 980735 4636980736 DATE 4/2/01

OWNER OR CONTRACTOR GD SMITH DEV. / COURTLAND PROPERTIES PHONE: Business 363-1622 Home

ADDRESS PO BOX 908 DAVIDSON NC 28036

LOCATION BRAWLEY SCHOOL - TL CANVASBACK - TL REGENCY - TR HIGHTOWER - ON LT 123 Hightower Ct.

SUBDIVISION REGENCY LAKE VILLAGE BLOCK / SECTION EF LOT 17 LOT AREA .48AC SITE CLASS. PS DESIGN FLOW 360GPD L.T.A.R. .36GPD/FT²

Septic Tank: 1000 Gallons; STB 354 Date 7/6/01

Pump Tank: 1000 Gallons; PT 313 Date 4/30/01

Pump Make: Model Serial No.

Nitrification Fields 1 Square Feet 900 Linear Feet 300

No Lines 4@75' Trench Width 36" Max Trench Bottom Depth 36" Gravel Depth N/A

☑ New System ☐ Repair System Type: I, II, (III), IV, V, VI

System Description: PUMP 25% REDUCTION

Repair System Description: SOME LP PANEL

Maintenance Agreement Required: ☐ Yes ☑ No

☑ House/Mod. Home ☐ Mobile Home ☐ Business ☐ Other

No. Bedrooms 3 No. Bathrooms 2 No. Employees


☐ Slab ☑ Crawl Space ☐ Basement w/plumbing ☐ Basement wo/plumbing

Water Supply: ☐ Individual ☐ Public ☑ Community

Comments:/Conditions: 1) MISTAKE BY HEALTH DEPT. - DRIVE AND PRESSURE MANIFOLD SWITCHED TO OTHER SIDE.

Comments:/Conditions:

INITIAL SITE SKETCH 1" = 50'

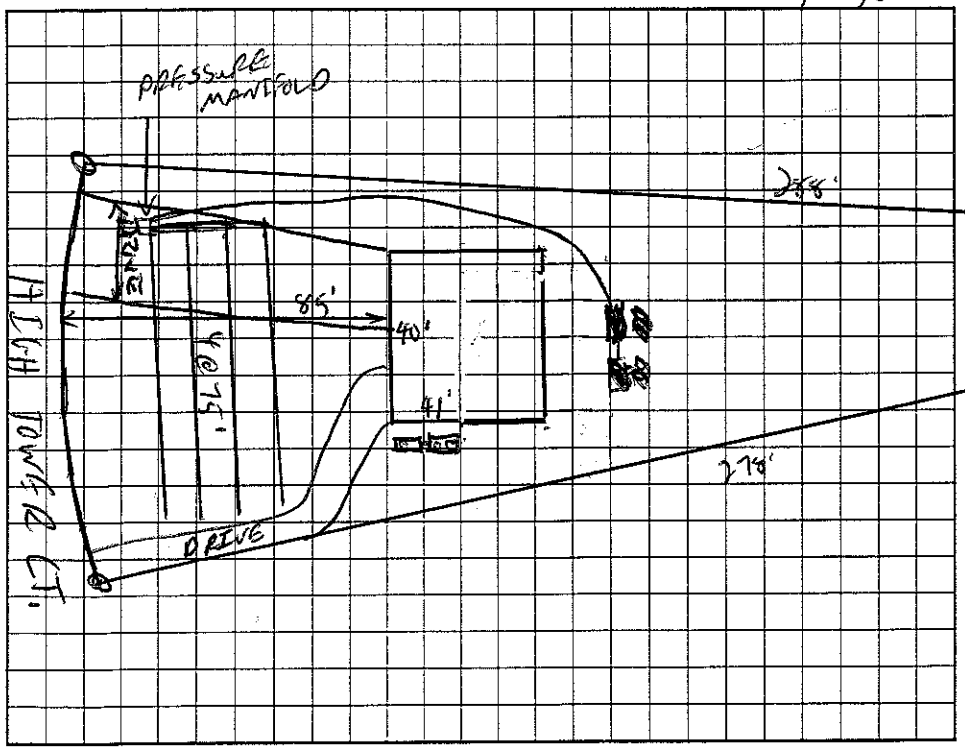

AS BUILT SKETCH

Install in 3 @ 60'

Permit can be suspended or revoked if any false information is supplied toward securing the permit/any unauthorized changes are made to the site/any unauthorized changes are made in the installation of the system. Improvement Permit with plat valid without expiration. Improvement Permit with site plan valid for sixty months. Authorization to Construct is valid for a period equal to that of Improvement Permit – not to exceed sixty months.

Signed: date 4/6/01 Installed by: MacLeod Const.

Improvement Permit by: date 4/2/01 Operation Permit by: Wesley Parks R.S. date 9/28/01

Authorization to Construct by: date 4/6/01 Existing System Inspection by: date

HEALTH DEPT. COPY: WHITE OWNER COPY (FINAL): YELLOW OWNER COPY (INITIAL): PINK