(10400) 4636981443

IREDELL COUNTY HEALTH DEPARTMENT

STATESVILLE 704-878-5305 MOORESVILLE 704-664-5281

IMPROVEMENT PERMIT / CERTIFICATE OF COMPLETION / OPERATION PERMIT / EXISTING SYSTEM INSPECTION

PROPERTY DESCRIPTION NO. 25201 DATE 9/27/96 TAX MAP NO. 2K 7 F 11 Watershed: [X] Yes [ ] No

OWNER OR CONTRACTOR James Brewer PHONE: Business _____ Home 664-3824

ADDRESS 515 Kemp RD. Mooresville NC. 28115

LOCATION High Tower Ct. Cornerlot to Regency TR High Tower on (R) just before cul de sac

SUBDIVISION Regency Lake Villas BLOCK / SECTION F LOT 10 LOT AREA 20,000 ft² SITE CLASS PS DESIGN FLOW 480 L.T.A.R. .3

Septic Tank: 1000 Gallons; STB 10825 Date 4/11/97 [X] New System [ ] Repair System Type: I, II, III, IV, V, VI

Pump Tank: _____ Gallons; PT _____ Date _____ System Description: 1K Plastic

Pump Make: _____ Model _____ Serial No. _____ Repair System Description: Same

Nitrification Field: No Fields 1 Square Feet 1600 Linear Feet 400 ± Maintenance Agreement Required: [ ] Yes [X] No

No Lines 4 Trench Width 36 Max Trench Bottom Depth 36 Gravel Depth 6" Stone [ ] Slab [X] Crawl Space [ ] Basement w/plumbing [ ] Basement wo/plumbing


[X] House/Mod. Home No. Bedrooms 4
[ ] Mobile Home No. Bathrooms 3
[ ] Business No. Employees _____
[ ] Other _____

Water Supply: [ ] Individual [X] Community [ ] Public


Comments:

Comments: Same as Curb to Const

INITIAL SITE SKETCH

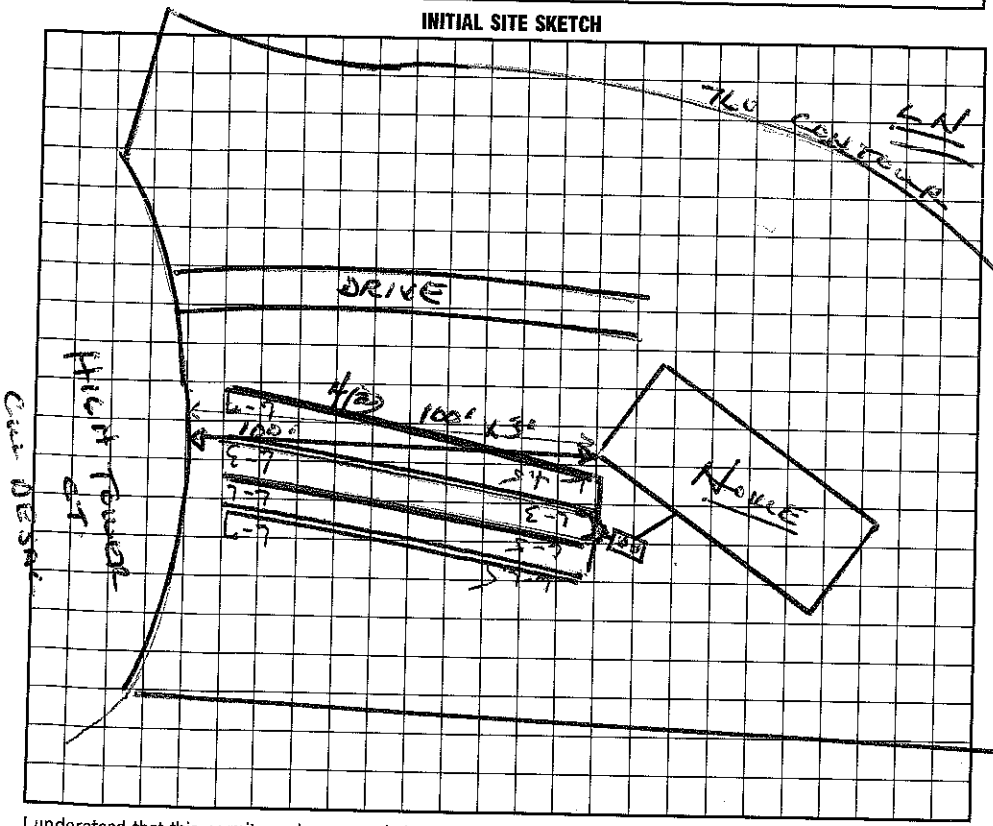

AS BUILT SKETCH

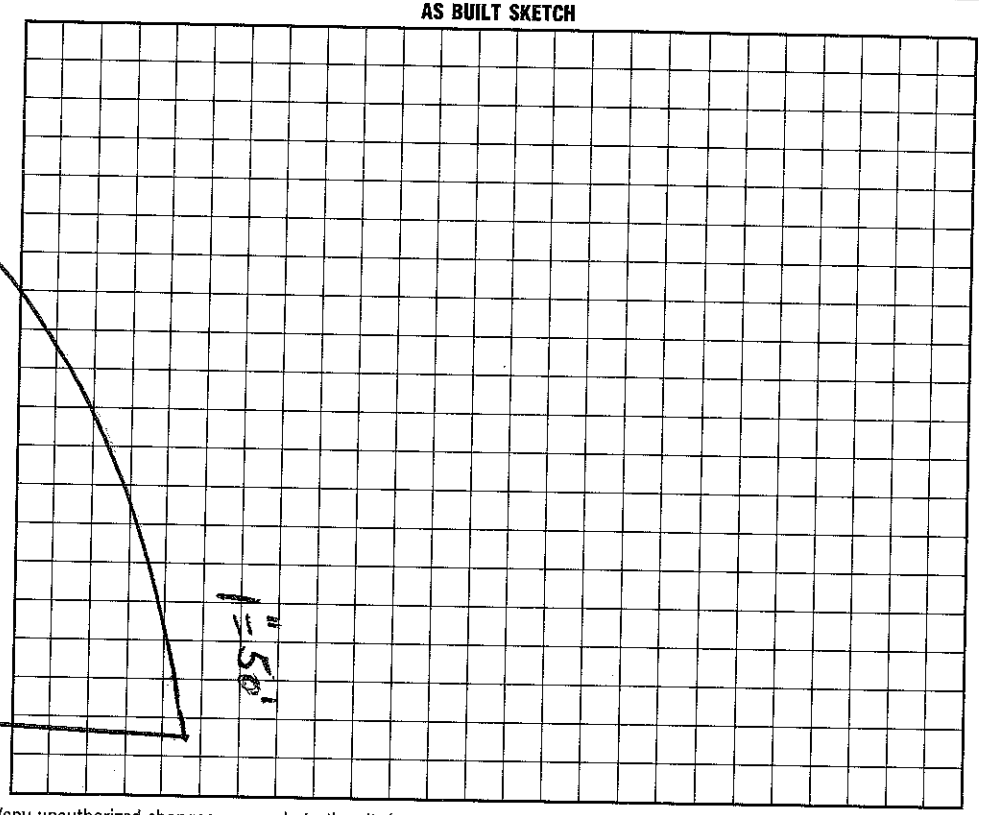

I understand that this permit can be suspended or revoked if any false information is supplied toward securing the permit/any unauthorized changes are made to the site/any unauthorized changes are made in the installation of the system.

Signed: [signature] Cert. Occupation to Construct valid for 60 months.

Improvement Permit by: Wesley Sparks RS. date 9/27/96

Existing System Inspection by: Wesley Sparks RS. date 9/27/96

Installed by: Rodney Ellis

Certificate of Completion by: Wesley Sparks RS date 7/8/97

Operation Permit by: Wesley Sparks RS date 7/8/97

HEALTH DEPT. COPY: WHITE INSPECTION COPY (FINAL): GREEN OWNER COPY (FINAL): YELLOW