IREDELL COUNTY HEALTH DEPARTMENT

Statesville Phone TR 3-7271 Mooresville Phone NO 3-1271

PERMIT TO INSTALL SEPTIC TANK

Permit No. _____ Permit Date 27 Nov 1970

Owner Regency Lake Address Chesterfield

Installed By Wesson Address Shelby


Location of Property Lot 12 - BLK F

Tank		Capacity		Length of Lines		Fixtures	
Block	( )	1000	(✓)	225'	(✓)	No. of Baths	( )
Precast	(✓)	1250	( )	250'	( )	Dishwasher	( )
		1500	( )	Other _____		Garbage Grdr.	( )
		Other _____				Other _____	

NOTIFY HEALTH DEPARTMENT AT LEAST EIGHT HOURS BEFORE TANK IS TO BE INSPECTED.

Final Inspection 27 Nov 1970 Approved (✓) Disapproved ( )

Remarks _____

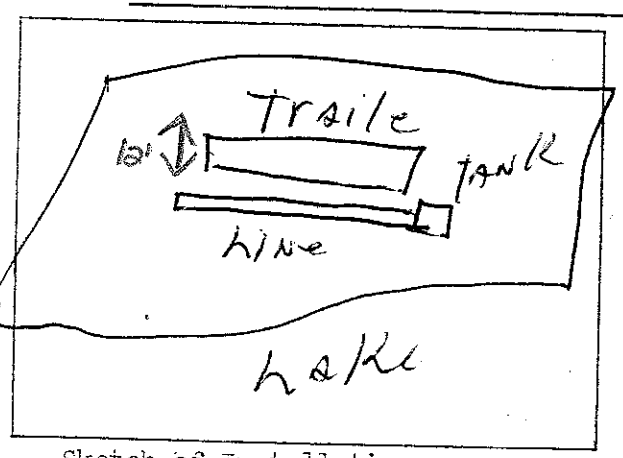

Sketch of Installation

Doug Stepp

Sanitarian

5/8/2002
Site visit & found Septic tank 5' from Trailer. Can not move MH any further back so if they want to use Existing Septic System need to stay with 12' MH. Otherwise new layout will need back hoe pits to check soil to see if suitable