IREDELL COUNTY HEALTH DEPARTMENT

STATESVILLE 704-878-5305 155.00 Paid MOORESVILLE 704-664-5281 155

IMPROVEMENT PERMIT / AUTHORIZATION TO CONSTRUCT / OPERATION PERMIT / EXISTING SYSTEM INSPECTION

PERMIT# 03327 PIN# 4636 98 3959 ~~4636 98 5818~~ (MS) 4636 98 4927 DATE 6/11/02

OWNER OR CONTRACTOR GD SMITH DEV. PHONE: Business 892-0409 Home

ADDRESS PO BOX 908 DAVIDSON NC 28036

LOCATION BRAWLEY SCHOOL - TL CANVASBACK - TL REGENCY - ON RT

SUBDIVISION REGENCY LAKE BLOCK / SECTION F LOT 26 & 27 LOT AREA .39 AC SITE CLASS. PS DESIGN FLOW 360GPD L.T.A.R. .30 R/A

Septic Tank: 1000 Gallons; STB 794 Date 10-12-02 ☑ New System ☐ Repair System Type: I, II, III, IV, V, VI

Pump Tank: 1000 Gallons; PT 283 Date 12-14-02 System Description: PUMP PIN PANEL

Pump Make: Model Serial No. Repair System Description: SAME

Nitrification Field: No Fields 1 Square Feet 400 Linear Feet 200 Maintenance Agreement Required: ☐ Yes ☑ No

No Lines 4@50' Trench Width 24" Max Trench Bottom Depth 36" Gravel Depth NA

☑ House/Mod. Home No. Bedrooms 3 ☐ Mobile Home No. Bathrooms 3 ☐ Business No. Employees ☐ Other


☐ Slab ☑ Crawl Space ☐ Basement w/plumbing ☐ Basement wo/plumbing

Water Supply: ☐ Individual ☐ Public ☑ Community


Comments:/Conditions: 1) SUPPLY LINE TO BE 36" OR GREATER TO AVOID DUCTILE IRON SLEEVE UNDER ~~ROAD~~ ROAD. 2) COMBO - 26 & 27

Comments:/Conditions: Tanks & lines Checked 1/28/03 Press. electric alarm checked 2/26/03

INITIAL SITE SKETCH 1" = 60'

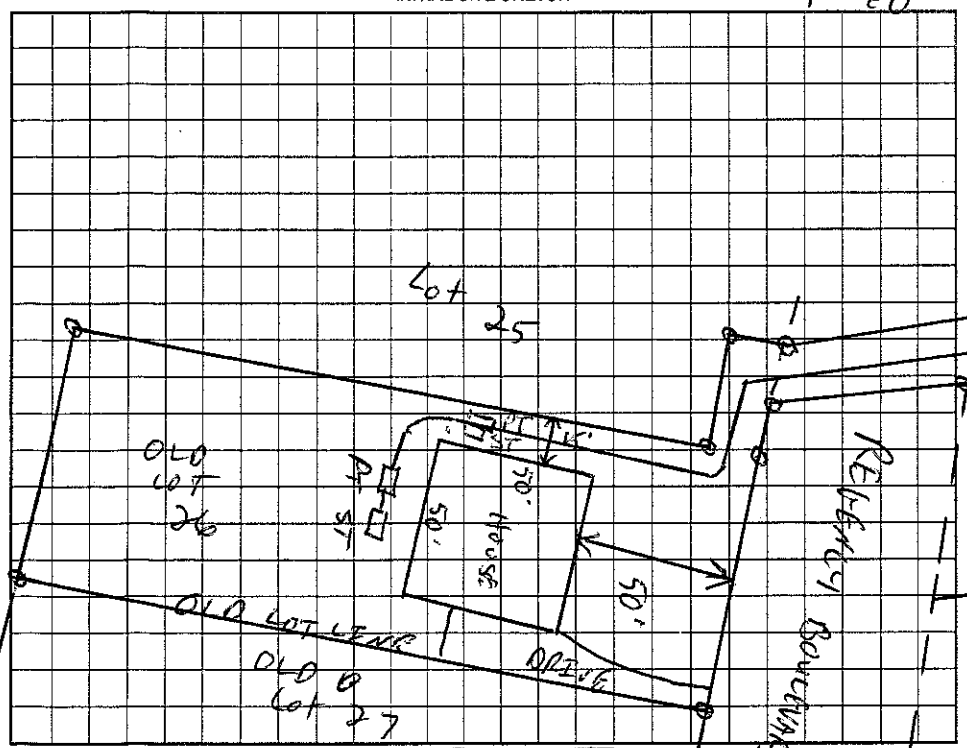

AS BUILT SKETCH

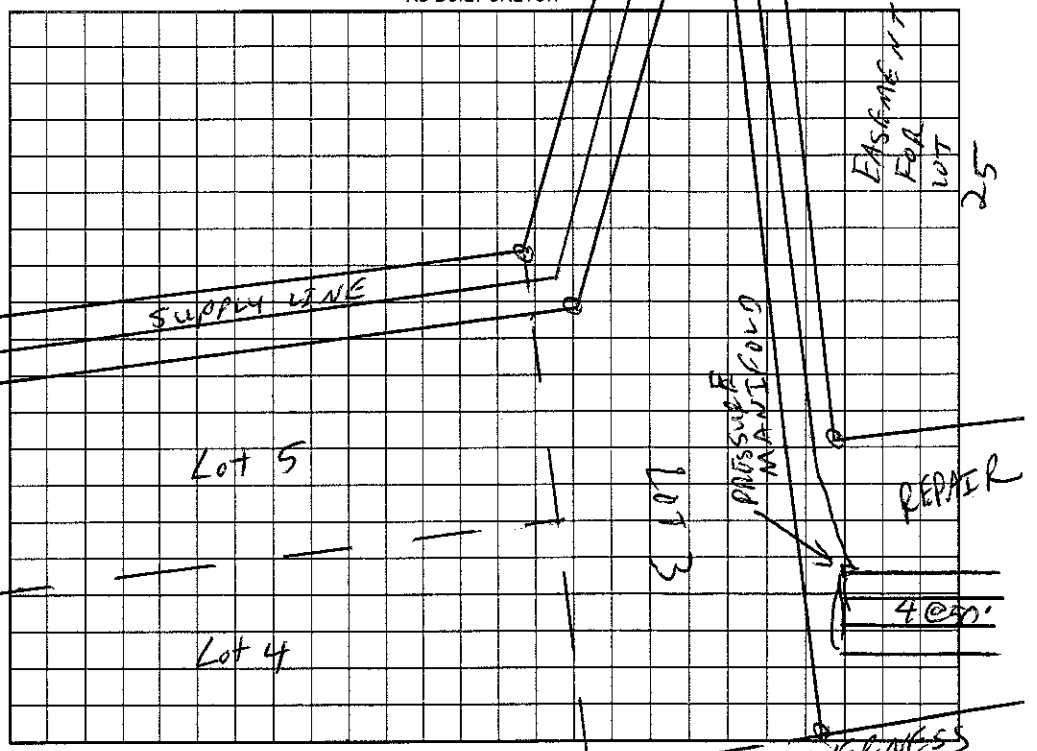

Permit can be suspended or revoked if any false information is supplied toward securing the permit/any unauthorized changes are made to the site/any unauthorized changes are made in the installation of the system. Improvement Permit with plat valid without expiration. Improvement Permit with site plan valid for sixty months. Authorization to Construct is valid for a period equal to that of Improvement Permit – not to exceed sixty months.

Signed: date 6/12/02 Installed by: R & H

Improvement Permit by: date 6/11/02 Operation Permit by: RS date 2/26/03

Authorization to Construct by: RS date 6/13/02 Existing System Inspection by: date

HEALTH DEPT. COPY: WHITE OWNER COPY (FINAL): YELLOW OWNER COPY (INITIAL): PINK