IREDELL COUNTY HEALTH DEPARTMENT

STATESVILLE 704-878-5305 125.00 Paid 3:30 MOORESVILLE 704-664-5281

IMPROVEMENT PERMIT / AUTHORIZATION TO CONSTRUCT / OPERATION PERMIT / EXISTING SYSTEM INSPECTION

PERMIT# 93329 PIN# 4636898800 4636988800 DATE 3/16/01

OWNER OR CONTRACTOR GD SMITH DEVELOPMENT / COURTLAND PROPERTIES PHONE: Business 892-0909 Home

ADDRESS PO BOX 908 DAVIDSON NC 28031

LOCATION BRAWLEY SCHOOL - TL CANVASBACK - TL REGENCY ON RT

SUBDIVISION REGENCY LAKE VILLAGE BLOCK / SECTION F LOT 31 LOT AREA .584AC SITE CLASS. PS DESIGN FLOW 360GPD L.T.A.R. .3gpd/ft²

Septic Tank: 1000 Gallons; STB 354 Date 7/5/00

Pump Tank: 1000 Gallons; PT 312 Date 5/15/01

Pump Make: Hydromatic Model SK50M Serial No. 2944233 01

Nitrification Field: No Fields 1 Square Feet 400 Linear Feet 200

No Lines 4 @ 50' Trench Width 24" Max Trench Bottom Depth 36" Gravel Depth N/A

☑ New System ☐ Repair System Type: I, II, III, IV, V, VI

System Description: PUMP PANEL

Repair System Description: SAME / NOT

Maintenance Agreement Required: ☐ Yes ☑ No REQUIRED

☑ House/Mod. Home ☐ Mobile Home ☐ Business ☐ Other

No. Bedrooms 3 No. Bathrooms 3 No. Employees


Water Supply: ☐ Individual ☐ Public ☑ ~~Community~~

☐ Slab ☑ Crawl Space ☐ Basement w/plumbing ☐ Basement wo/plumbing

Comments:/Conditions:

Comments:/Conditions:

INITIAL SITE SKETCH 1"=50'

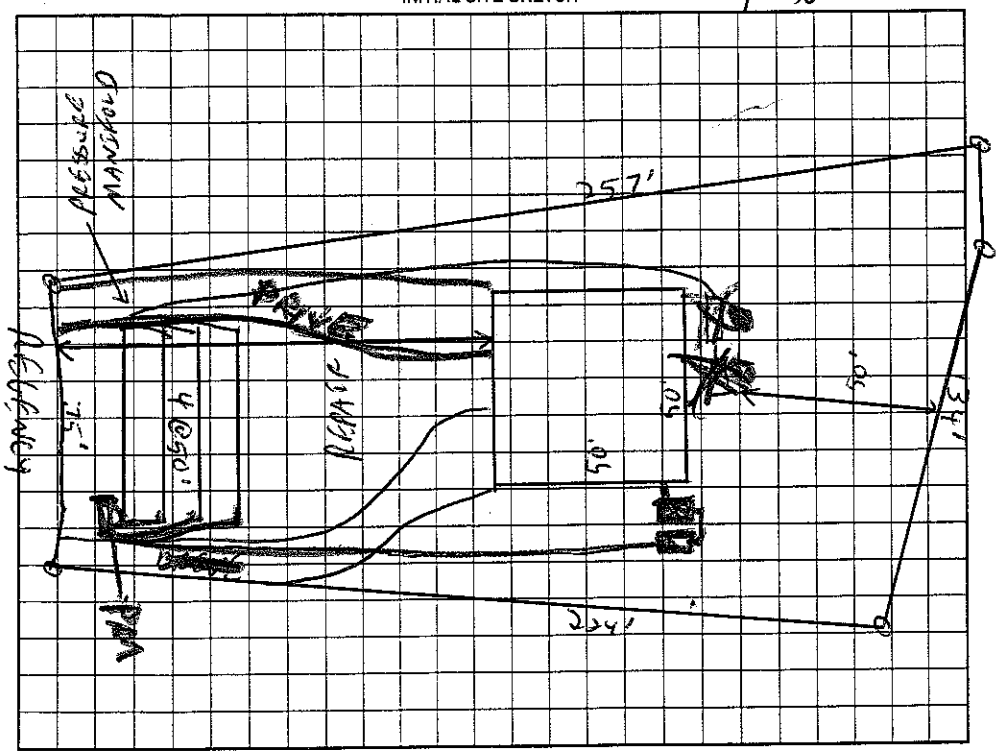

AS BUILT SKETCH

Permit can be suspended or revoked if any false information is supplied toward securing the permit/any unauthorized changes are made to the site/any unauthorized changes are made in the installation of the system. Improvement Permit with plat valid without expiration. Improvement Permit with site plan valid for sixty months. Authorization to Construct is valid for a period equal to that of Improvement Permit – not to exceed sixty months.

Signed: _____ date 3-16-01 Installed by: Macleod

Improvement Permit by: _____ date 3/16/01 Operation Permit by: Wesley Sparks RS date 8/10/01

Authorization to Construct by: _____ date _____ Existing System Inspection by: _____ date _____

HEALTH DEPT. COPY: WHITE OWNER COPY (FINAL): YELLOW OWNER COPY (INITIAL): PINK