IREDELL COUNTY HEALTH DEPARTMENT

Statesville Office (704) 878-5305 Mooresville Office (704) 660-3625 PERMIT # 207659

IMPROVEMENT PERMIT / AUTHORIZATION TO CONSTRUCT / OPERATION PERMIT / EXISTING SYSTEM

PIN # 4636 99 2085

APPLICANT: Westley Newsome APPLICANT ADDRESS: 142 Regency Rd Mooresville NC 28117

SITE ADDRESS: 142 Regency Rd. PHONE: ALT. PHONE: 704 763-9232

SITE DIRECTIONS: Brawley School Rd TL Canvasback TL Regency Rd on right B4 Inverness (Septic Easement)

SUBDIVISION: Regency Lake SECTION: F LOT # 23-25 LOT AREA: .46 acre DESIGN FLOW: 480gpd L.T.A.R.: .3

Septic Tank 1000 (gal) STB Date
Pump Tank 1000 (gal) PT Date
Pump Make Myers Model ME100 Serial #
Nitrification Fields 1 # Lines 2 Linear Ft: 70ft
Trench Width min 24" Max. Trench Bottom Depth 36" Gravel Depth N/A

☐ New System ☐ Repair ☒ Expansion System Type: I II III IV V VI
System Description: Pump (on) Panel Block
Repair System Description: LP Panel Blk
Maintenance Agreement Required: ☐ YES ☒ NO
☐ GRAVITY ☒ PRESSURE

☒ Residence No. Bedrooms 4
☐ Business No. Persons 8
☐ Other No. Employees
☐ Slab ☐ Crawl Space
☒ Basement w/plumbing ☐ Basement w/o plumbing


Water Supply across Street
☐ Private
☐ Public
☒ Community

Comments / Conditions: Upgraded Septic System from 3Bdrms to 4 Bedrooms. Add 2 lines @ 35Ft each, relocate Pressure Manifold to top line PL200


4/6/15 Checked new drainlines
4/7/15 Changed Elect & Alarm

(Existing Drainfield has 4-50ft lines)

INITIAL SITE SKETCH

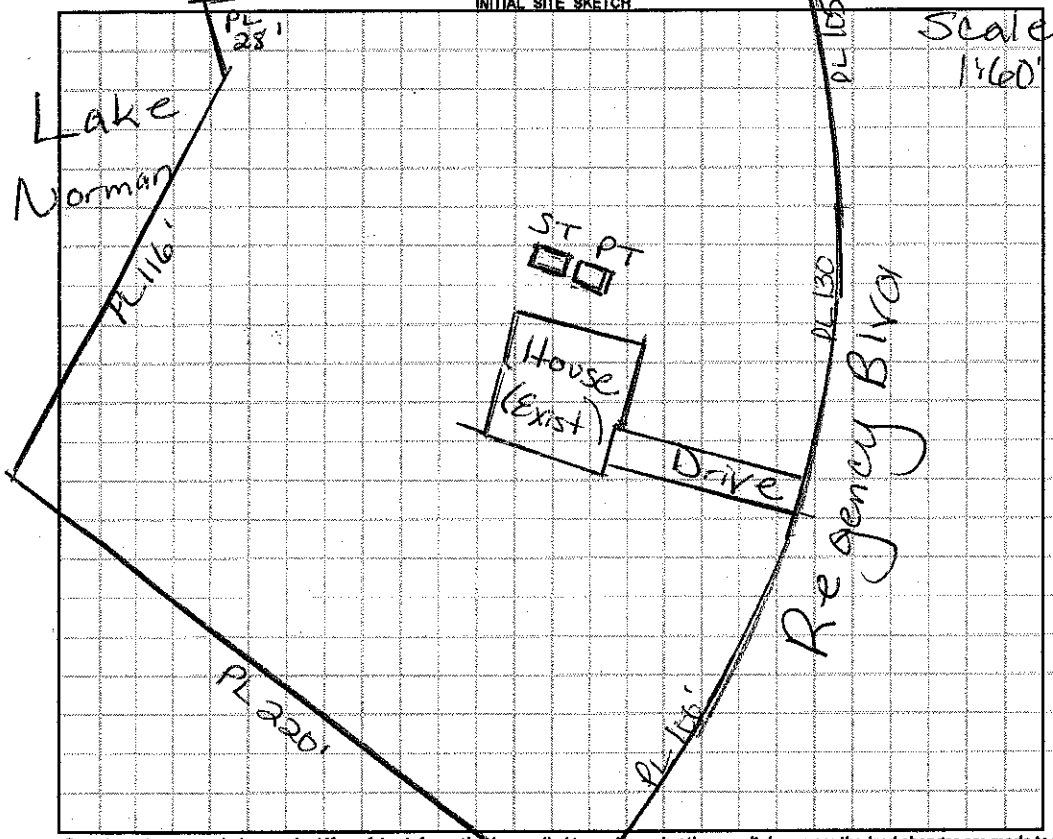

AS BUILT SKETCH

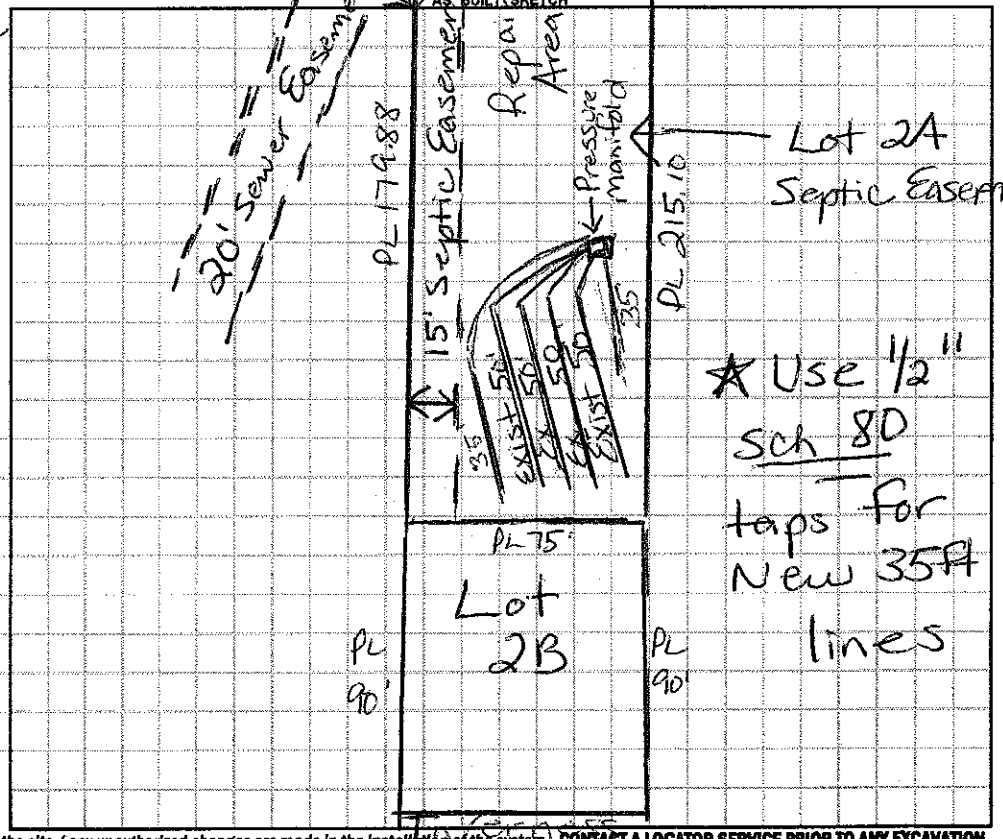

Permit can be suspended or revoked if any false information is supplied toward securing the permit / any unauthorized changes are made to the site / any unauthorized changes are made in the installation of the system. **CONTACT A LOCATOR SERVICE PRIOR TO ANY EXCAVATION**

☐ **IMPROVEMENT PERMIT** *with plat valid without expiration.* ☐ **IMPROVEMENT PERMIT** *with site plan valid for 60 mos.* ☐ **AUTHORIZATION TO CONSTRUCT** *valid for period equal to IMPROVEMENT PERMIT--not to exceed 60 mo.*

Owner / Applicant Signature: Date: 1/27/15 Installed by: Autry Septic

IMPROVEMENT PERMIT by: Date: 1/26/15 OPERATION PERMIT by: Date: 4/7/15

AUTHORIZATION TO CONSTRUCT by: Date: 1/26/15 Existing System Inspected by: Date:

Health Dept. Copy - WHITE Applicant (Final Approval) - YELLOW Applicant (Conditional Approval) - PINK