IREDELL COUNTY HEALTH DEPARTMENT

STATESVILLE 704-878-5305 155.00 Paid MOORESVILLE 704-664-5281

IMPROVEMENT PERMIT / AUTHORIZATION TO CONSTRUCT / OPERATION PERMIT / EXISTING SYSTEM INSPECTION

PERMIT# 093326 PIN# 4636993013 4636-99-2085

OWNER OR CONTRACTOR GOSMITH DEVELOPMENT PHONE: Business 892-0909 Home DATE 6/12/02

ADDRESS PO Box 908 DAVIDSON NC 28031

LOCATION BRAWLEY SCHOOL - TL CANVASBACK - TL REGENCY - ON RT

SUBDIVISION REGENCY LAKE BLOCK / SECTION F LOT 25 LOT AREA .46 AC SITE CLASS PS DESIGN FLOW 360GPD L.T.A.R. .3600/KTZ

Septic Tank: 1000 Gallons; STB 794 Date 10-12-02

Pump Tank: 1000 Gallons; PT 283 Date 12-2-02

Pump Make: Myers Model Serial No.

Nitrification Field: No Fields 1 Square Feet 400 Linear Feet 200

No Lines 4@50' Trench Width 24" Max Trench Bottom Depth 36" Gravel Depth N/A

☑ New System ☐ Repair System Type: I, II, III, IV, V, VI

System Description: PUMP PANEL

Repair System Description: LP PANEL

Maintenance Agreement Required: ☐ Yes ☑ No

☑ House/Mod. Home No. Bedrooms 3

☐ Mobile Home No. Bathrooms 2

☐ Business No. Employees

☐ Other


☐ Slab ☑ Crawl Space ☐ Basement w/plumbing ☐ Basement wo/plumbing

Water Supply: ☐ Individual ☐ Public ☑ ~~Community~~


Comments/Conditions: 1) SLEEVE UNDER ROAD IF SUPPLY LINE IS NOT 36" DEEP OR MORE. 2) 24, 25 & 23 combination 3) SEE PLAT FOR MORE DETAILS ON SUPPLY LINE & DRAINFIELD EASEMENT

Comments/Conditions: Tanks & lines checked 1/25/03

INITIAL SITE SKETCH

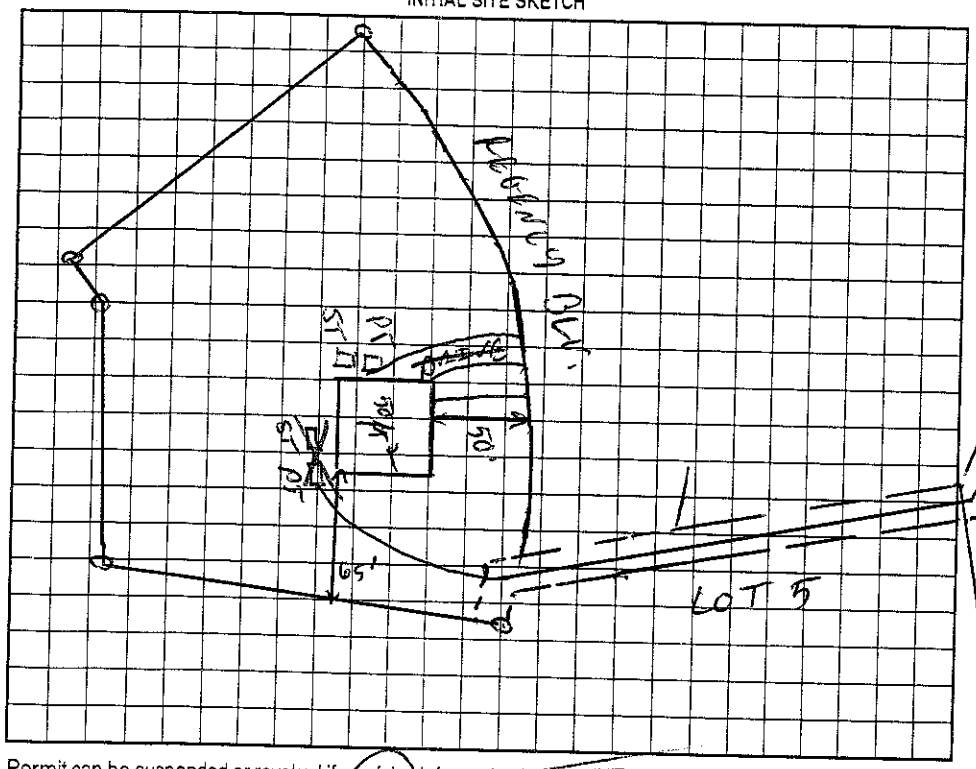

AS BUILT SKETCH

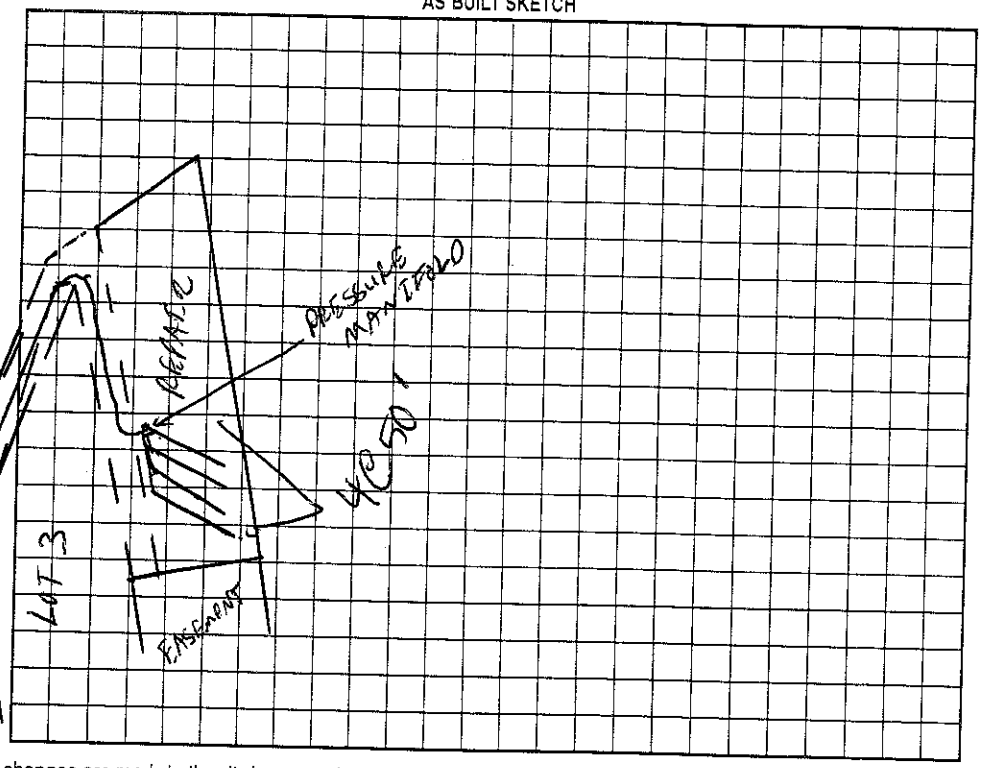

Permit can be suspended or revoked if any false information is supplied toward securing the permit/any unauthorized changes are made to the site/any unauthorized changes are made in the installation of the system. Improvement Permit with plat valid without expiration. Improvement Permit with site plan valid for sixty months. Authorization to Construct is valid for a period equal to that of Improvement Permit – not to exceed sixty months.

Signed: date 6/12/02 Installed by: R & H Inc

Improvement Permit by: C. Hughes RS date 6/12/02 Operation Permit by: RS date 2/25/03

Authorization to Construct by: C. Hughes RS date 6/13/02 Existing System Inspection by: date

HEALTH DEPT. COPY: WHITE OWNER COPY (FINAL): YELLOW OWNER COPY (INITIAL): PINK