IREDELL COUNTY HEALTH DEPARTMENT

STATESVILLE 704-878-5305 175.00 Paid MOORESVILLE 704-664-5281

IMPROVEMENT PERMIT / AUTHORIZATION TO CONSTRUCT / OPERATION PERMIT / EXISTING SYSTEM INSPECTIO

PERMIT# 093260 PIN# 4636992339 4636-99-2422 DATE 12/10/01

OWNER OR CONTRACTOR GO SMITH DEV. / DEAN HABERL PHONE: Business 892-0909 Home

ADDRESS PO Box 908 DAVIDSON - NC 28031

LOCATION BRAWLEY School - TL CANVASBACK - TL REGENCY - ON LT.

SUBDIVISION REGENCY LAKE BLOCK / SECTION E LOT 8 LOT AREA 1.16 AC SITE CLASS PS DESIGN FLOW 360 GPD L.T.A.R. .25 gal/ft2

Septic Tank: 1000 Gallons; STB 312 Date 4-16-03

Pump Tank: Gallons; PT Date

Pump Make: Model Serial No.

Nitrification Field: No Fields 1 Square Feet 500 Linear Feet 250

No Lines 5 @ 50' Trench Width 24" Max Trench Bottom Depth 36" Gravel Depth N/A

☑ New System ☐ Repair System Type: I, II, III, IV, V, VI

System Description: GRAVITY PANEL

Repair System Description: LPP

Maintenance Agreement Required: ☐ Yes ☑ No

☑ House/Mod. Home No. Bedrooms 3

☐ Mobile Home No. Bathrooms 3

☐ Business No. Employees

☐ Other


☐ Slab ☑ Crawl Space ☐ Basement w/plumbing ☐ Basement wo/plumbing

Water Supply: ☐ Individual ☐ Public ☑ Community


Comments:/Conditions: COMBINED lot 8-9

Comments:/Conditions: Lines installed perpendicular to house.

INITIAL SITE SKETCH 1" = 50'

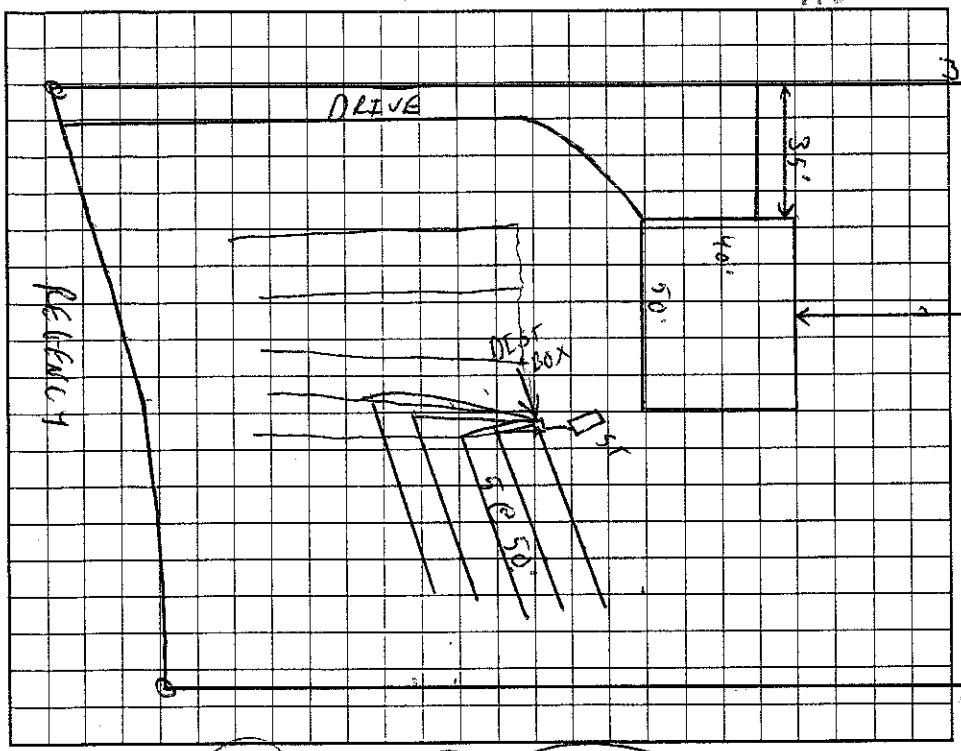

AS BUILT SKETCH

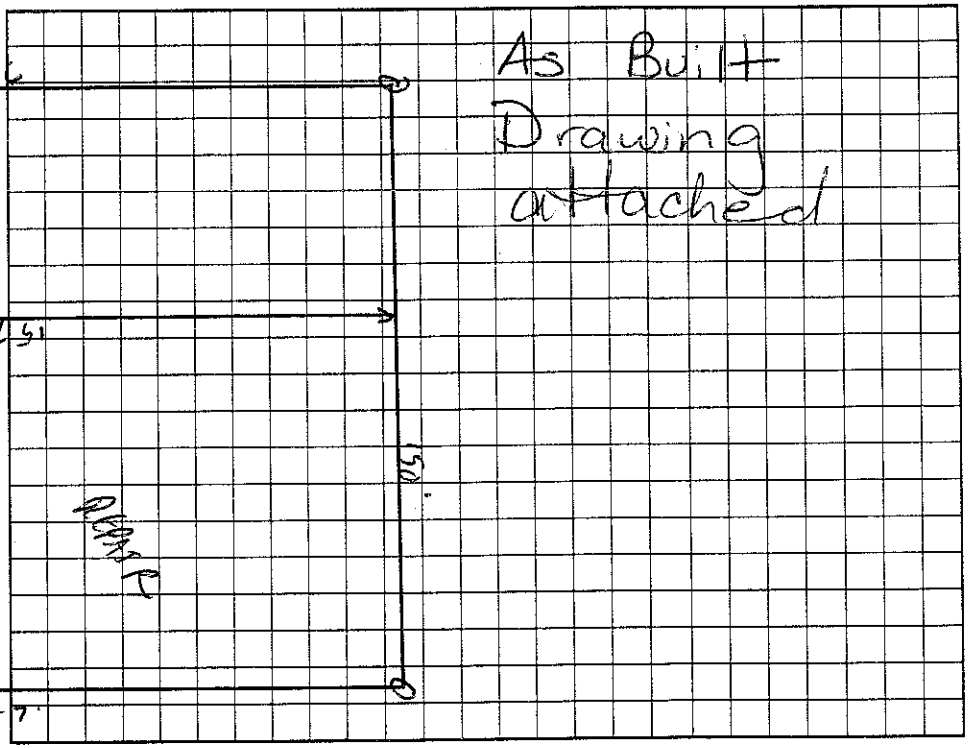

Permit can be suspended or revoked if any false information is supplied toward securing the permit/any unauthorized changes are made to the site/any unauthorized changes are made in the installation of the system. Improvement Permit with plat valid without expiration. Improvement Permit with site plan valid for sixty months. Authorization to Construct is valid for a period equal to that of Improvement Permit – not to exceed sixty months.

Signed: date 12/12/01 Installed by: R&H

Improvement Permit by: HS date 12/10/01 Operation Permit by: Maria H. Dotson R.S. date 7/17/03

Authorization to Construct by: HS date 10/31/02 Existing System Inspection by: date

HEALTH DEPT. COPY: WHITE OWNER COPY (FINAL): YELLOW OWNER COPY (INITIAL): PINK

IREDELL COUNTY HEALTH DEPARTMENT

STATESVILLE 704-878-5305 MOORESVILLE 704-664-5281

IMPROVEMENT PERMIT / AUTHORIZATION TO CONSTRUCT / OPERATION PERMIT / EXISTING SYSTEM INSPECTION

PERMIT# 093260 PIN# 4636992339 DATE 7/18/2003

OWNER OR CONTRACTOR Dean Haberl PHONE: Business _____ Home _____

ADDRESS _____

LOCATION Brawley School TL Canvasback TL Regency on left

SUBDIVISION Regency Lake BLOCK / SECTION E LOT 8 LOT AREA _____ SITE CLASS PS DESIGN FLOW 360gpd L.T.A.R. .25

Septic Tank: 1000 Gallons; STB 312 Date 4-16-03
Pump Tank: _____ Gallons; PT _____ Date _____
Pump Make: _____ Model _____ Serial No. _____
Nitrification Field: No Fields 1 Square Feet 500 Linear Feet 250
No Lines 5 @ 50 Trench Width 24" Max Trench Bottom Depth 36" Gravel Depth N/A

☒ New System ☐ Repair System Type: I, II, III, IV, V, VI
System Description: Gravity Panel
Repair System Description: LPP
Maintenance Agreement Required: ☐ Yes ☐ No


☒ House/Mod. Home No. Bedrooms 3
☐ Mobile Home No. Bathrooms 3
☐ Business No. Employees ____
☐ Other _____
☐ Slab ☒ Crawl Space ☐ Basement w/plumbing ☐ Basement wo/plumbing

Water Supply:
☐ Individual
☐ Public
☒ Community


Comments:/Conditions: Combined 8 & 9

Comments:/Conditions:

INITIAL SITE SKETCH

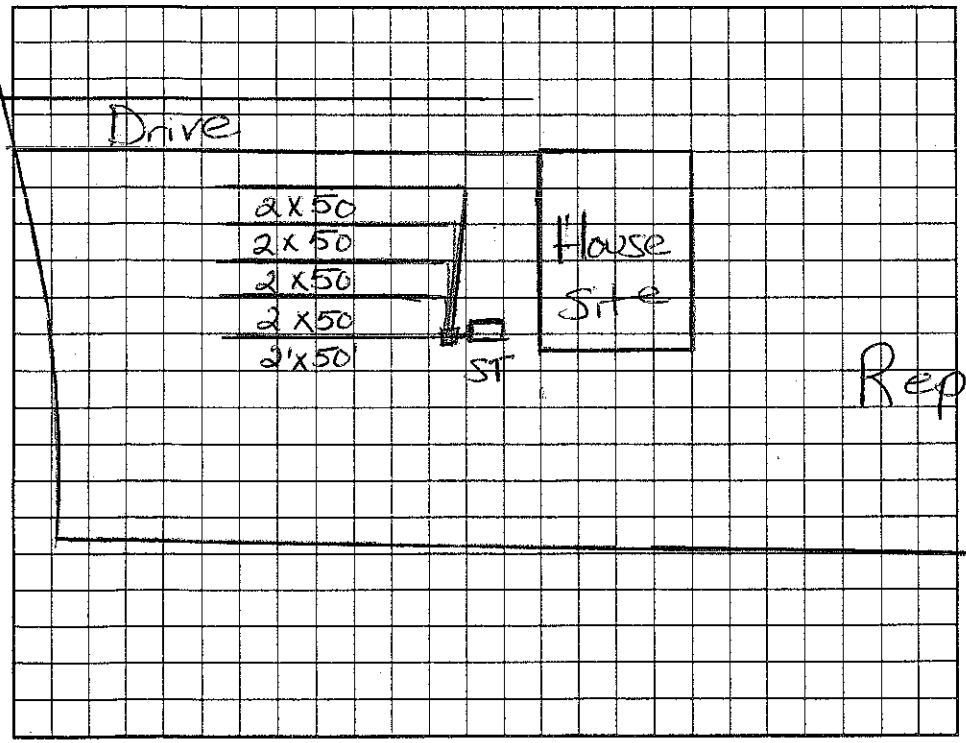

AS BUILT SKETCH

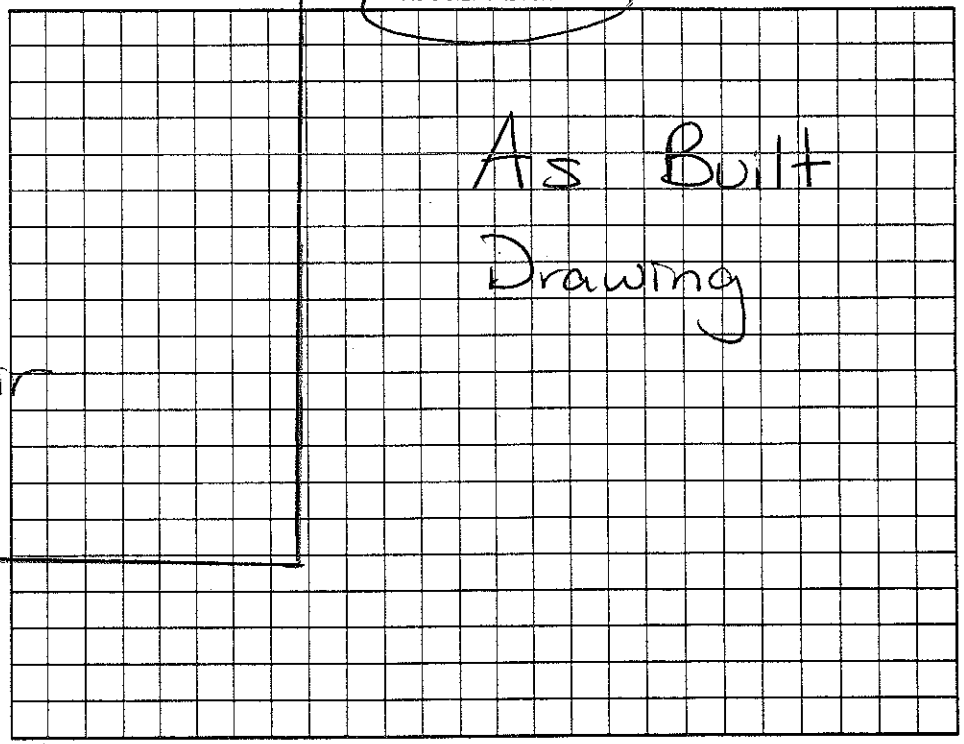

Permit can be suspended or revoked if any false information is supplied toward securing the permit/any unauthorized changes are made to the site/any unauthorized changes are made in the installation of the system. Improvement Permit with plat valid without expiration. Improvement Permit with site plan valid for sixty months. Authorization to Construct is valid for a period equal to that of Improvement Permit – not to exceed sixty months.

Signed: _____ date _____

Improvement Permit by: _____ date _____

Authorization to Construct by: _____ date _____

Installed by: R & H

Operation Permit by: Maria H Dotson R.S. date 7/17/03

Existing System Inspection by: _____ date _____

HEALTH DEPT. COPY: WHITE OWNER COPY (FINAL): YELLOW OWNER COPY (INITIAL): PINK