IREDELL COUNTY HEALTH DEPARTMENT

Statesville Office (704) 878-5305 | Mooresville Office (704) 660-3625 (ALP) | PERMIT # 210256

IMPROVEMENT PERMIT / AUTHORIZATION TO CONSTRUCT / OPERATION PERMIT / EXISTING SYSTEM

PIN # 4636995232

APPLICANT: AJ Mac Minn | APPLICANT ADDRESS: 326 Winding Shore Trail Statesville, NC 28166

SITE ADDRESS: 147 Regency Rd Mooresville, NC 28117 | PHONE: | ALT. PHONE: 704 363 3959

SITE DIRECTIONS: Brawley School Rd TL Canvasback TL Regency on left at Inverness Lp.

SUBDIVISION: Regency Lake Village | SECTION: E | LOT # 4 & 5 | LOT AREA: | DESIGN FLOW: 360 gpd | L.T.A.R.: .3


Septic Tank	1000 (gal)	STB		Date		☐ New System ☐ Repair ☐ Expansion	System Type: I II III IV V VI	☒ Residence	No. Bedrooms 3
Pump Tank	1000 (gal)	PT		Date		System Description: EXIST. Pump-PM Panel Blk		☐ Business	No. Persons 6
Pump Make		Model		Serial #		Repair System Description: Same		☐ Other	No. Employees
# Nitrification Fields	1	# Lines	5 @ 50'	Linear Ft:	200'	Maintenance Agreement Required:	☐ YES ☒ NO	☐ Slab	☒ Crawl Space
Trench Width	24"	Max. Trench Bottom Depth	36"	Gravel Depth	N/A	☐ GRAVITY	☒ PRESSURE	☐ Basement w/plumbing	☐ Basement w/o plumbing

Water Supply: ☐ Private ☐ Public ☒ Community

Comments / Conditions: Must keep deck at least 5FT from Septic System.

The proposed roof addition to deck & 12'x12' Deck does not appear to impact the existing Septic System.

INITIAL SITE SKETCH

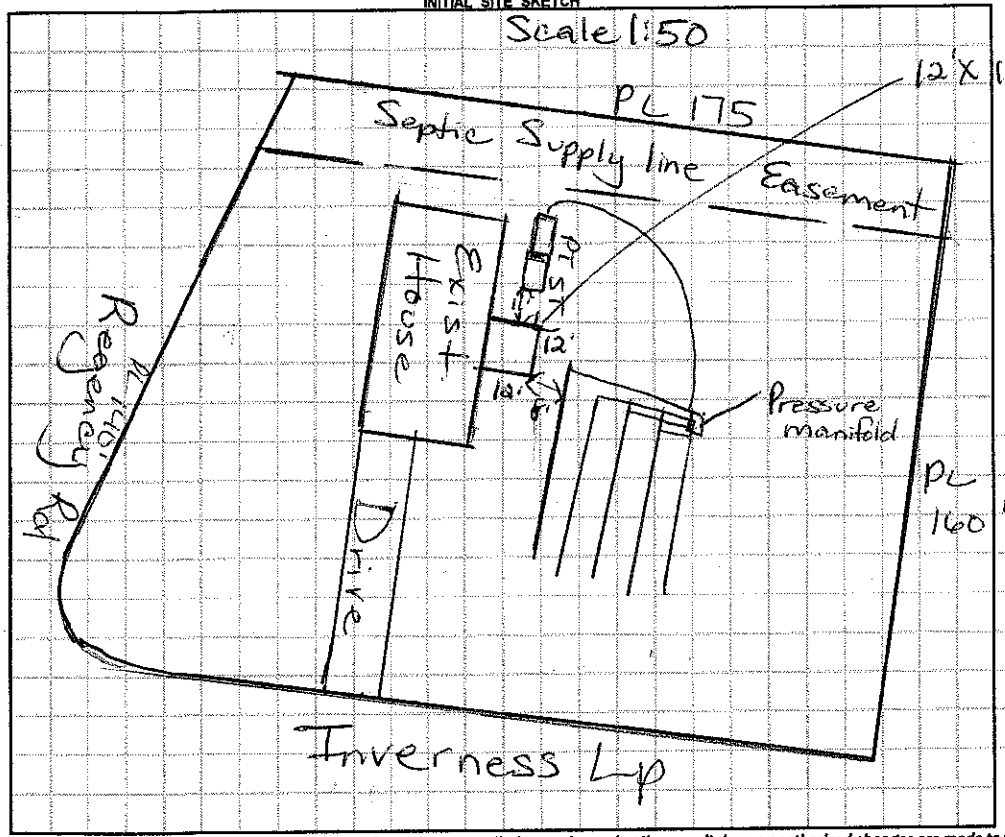

AS BUILT SKETCH

Permit can be suspended or revoked if any false information is supplied toward securing the permit / any unauthorized changes are made to the site / any unauthorized changes are made in the installation of the system. **CONTACT A LOCATOR SERVICE PRIOR TO ANY EXCAVATION**

☐ **IMPROVEMENT PERMIT** *with plat valid without expiration.* ☐ **IMPROVEMENT PERMIT** *with site plan valid for 60 mos.* ☐ **AUTHORIZATION TO CONSTRUCT** *valid for period equal to IMPROVEMENT PERMIT--not to exceed 60 mo.*

Owner / Applicant Signature: AJ Mac Minn | Date: 6/15/15 | Installed by:

IMPROVEMENT PERMIT by: | Date: | OPERATION PERMIT by: | Date:

AUTHORIZATION TO CONSTRUCT by: | Date: | Existing System Inspected by: Maria H. Dotson RS | Date: 6/9/15

Health Dept. Copy - WHITE Applicant (Final Approval) - YELLOW Applicant (Conditional Approval) - PINK