IREDELL COUNTY HEALTH DEPARTMENT

Statesville Office (704) 878-5305 Mooresville Office (704) 660-3625 PERMIT # 142087

IMPROVEMENT PERMIT / AUTHORIZATION TO CONSTRUCT / OPERATION PERMIT / EXISTING SYSTEM

PIN # 4636-99-5919

APPLICANT: KEVIN MILLER APPLICANT ADDRESS: 128 FARMSTEAD LN

SITE ADDRESS: SAME PHONE: 704-497-4886 ALT. PHONE:


SITE DIRECTIONS: BSR, UTURN @ CANVASBACK, TR FARMSTEAD ON R

SUBDIVISION: FARMSTEAD ESTATES SECTION: 2 LOT # 68 LOT AREA: DESIGN FLOW: 480 L.T.A.R.: .3

Septic Tank	1000 (gal)	STB	525	Date	9-25-13	☒ New System	☐ Repair	☐ Expansion	System Type: I II (III) IV V VI	☒ Residence	No. Bedrooms 4	Water Supply
Pump Tank	(gal)	PT		Date		System Description:	25% REDUCTION			☐ Business	No. Persons	☒ Private
Pump Make		Model		Serial #		Repair System Description:	SAME			☐ Other	No. Employees	☐ Public
# Nitrification Fields	1	# Lines	4@100'	Linear Ft:	400'	Maintenance Agreement Required:	☐ YES	☒ NO		☒ Slab	☐ Crawl Space	☐ Community
Trench Width	36"	Max. Trench Bottom Depth	36"	Gravel Depth	—		☒ GRAVITY	☐ PRESSURE		☐ Basement w/plumbing	☐ Basement w/o plumbing	

Comments / Conditions:

INITIAL SITE SKETCH

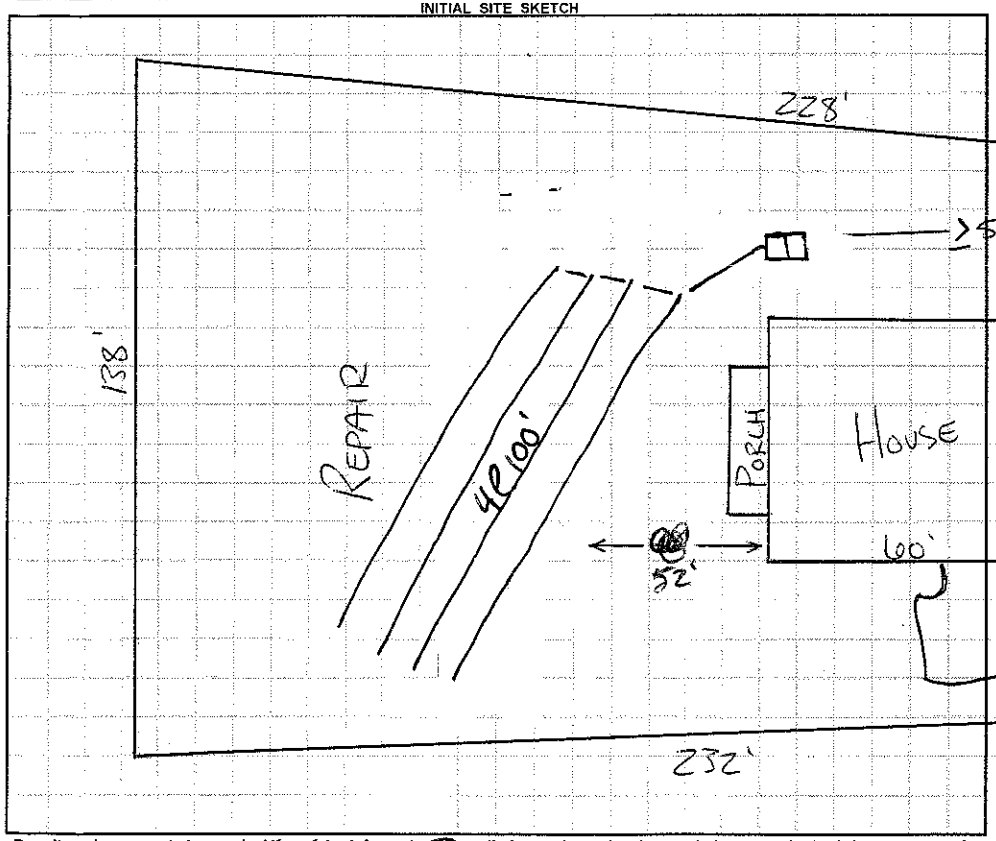

AS BUILT SKETCH

1" = 40'

Permit can be suspended or revoked if any false information is supplied toward securing the permit / any unauthorized changes are made to the site / any unauthorized changes are made in the installation of the system. **CONTACT A LOCATOR SERVICE PRIOR TO ANY EXCAVATION**

☐ **IMPROVEMENT PERMIT** *with plat valid without expiration.* ☒ **IMPROVEMENT PERMIT** *with site plan valid for 60 mos.* ☒ **AUTHORIZATION TO CONSTRUCT** *valid for period equal to IMPROVEMENT PERMIT--not to exceed 60 mo.*

Owner / Applicant Signature: Kevin Miller Date: 10/22/13 Installed by: Rowan Septic

IMPROVEMENT PERMIT by: Date: 10-17-13 OPERATION PERMIT by: Date: 11-14-13

AUTHORIZATION TO CONSTRUCT by: Date: 10-17-13 Existing System Inspected by: Date:

Health Dept. Copy - WHITE Applicant (Final Approval) - YELLOW Applicant (Conditional Approval) - PINK