4636-99-6162

...LL COUNTY HEALTH DEPARTMENT

STATESVILLE 704-878-5305 MOORESVILLE 704-664-5281

IMPROVEMENT PERMIT / CERTIFICATE OF COMPLETION / OPERATION PERMIT / EXISTING SYSTEM INSPECTION

PROPERTY DESCRIPTION NO. 20437 DATE 3/16/95 TAX MAP NO. 2E-7-D-14 Watershed: ☐ Yes ☐ No

OWNER OR CONTRACTOR Brian Hartwick PHONE: Business Home 664-6636

ADDRESS 232 Berwick Lane, Mooresville

LOCATION 1100 LF on Canvasback / LF on Regency, At Corner of Inverness 155 Regency Rd.

SUBDIVISION Regency Lake Village BLOCK / SECTION D LOT 14 LOT AREA 184x103 SITE CLASS. PS DESIGN FLOW 360 L.T.A.R. ~0.4 gpd

Septic Tank: 1000 Gallons; STB 794 Date 4/11/95

Pump Tank: Gallons; PT Date

Pump Make: Model Serial No.

Nitrification Field: No Fields 1 Square Feet 900 Linear Feet 300

No Lines 3 Trench Width 3 Max Trench Bottom Depth 36" Gravel Depth 12"

☑ New System ☐ Repair System Type: I, II, III, IV, V, VI

System Description: Conv Crawl

Repair System Description: Crawl PPBDS

Maintenance Agreement Required: ☐ Yes ☑ No

☐ ~~Mod. Home~~ ☐ Mobile Home ☐ Business ☐ Other

No. Bedrooms 3 No. Bathrooms 2 No. Employees


☐ Slab ☑ Crawl Space ☐ Basement w/plumbing ☐ Basement wo/plumbing

Water Supply: ☐ Individual ☑ Community ☐ Public

Comments: Drop Boxes OK, Line lengths may vary to obtain 300' total.

Comments:

INITIAL SITE SKETCH

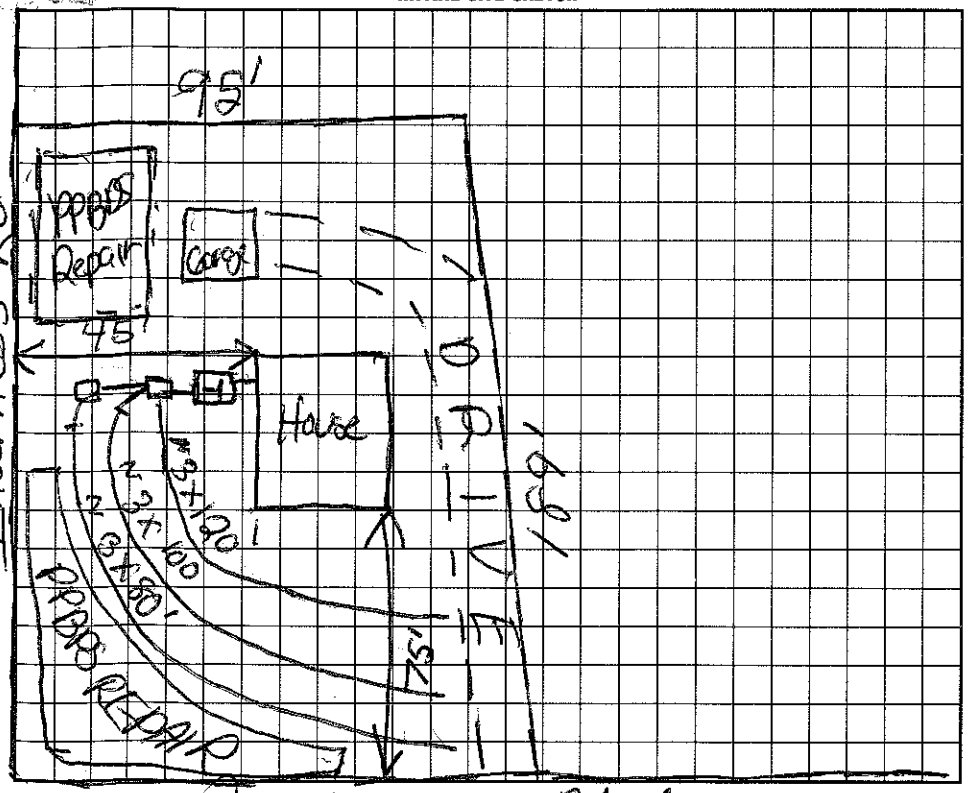

AS BUILT SKETCH

I understand that this permit can be suspended or revoked if any false information is supplied toward securing the permit/any unauthorized changes are made to the site/any unauthorized changes are made in the installation of the system. Improvement Permit is valid for 60 months from date of issuance.

Signed: 9/16/95

Improvement Permit by: date

Existing System Inspection by: date

Installed by: Tim Ammons

Certificate of Completion by: Wesley Sparks RS date 9/20/95

Operation Permit by: date

HEALTH DEPT. COPY: WHITE INSPECTION COPY (FINAL): GREEN OWNER COPY (FINAL): YELLOW INSPECTION COPY (INITIAL): PINK OWNER COPY (INITIAL): GOLD