IREDELL COUNTY HEALTH DEPARTMENT

PIN# 4636-99-6939

STATESVILLE 704-878-5305 MOORESVILLE 704-664-5281

IMPROVEMENT PERMIT / CERTIFICATE OF COMPLETION / OPERATION PERMIT / EXISTING SYSTEM INSPECTION

PROPERTY DESCRIPTION NO. 16561 DATE June 29, 93 TAX MAP NO. 2K-19A-37

OWNER OR CONTRACTOR Eric & Catherine Chiarese PHONE: Business Home 597-7407

ADDRESS 8304 Paces Oaks Blvd. Charlotte 28213

LOCATION 1100 Tr Farmstead Cave ~500' on Right

SUBDIVISION Farmstead BLOCK / SECTION B LOT 67 LOT AREA SITE CLASS. IS L.T.A.R. .35

Water Supply: ☑ Individual ☐ Community ☐ Public

Septic Tank: ~~750~~ 1000 Gallons; STB 358 Date 4-20-93

Pump Tank: Gallons; PT Date

Nitrification Field: No Fields 1 Square Feet 1050 Linear Feet 350

No Lines 4 Trench Width 36" Trench Depth 24" Gravel Depth 12"

☑ New System ☐ Repair System Type: I (II) III, IV, V, VI

System Description: gravity conventional

Repair System Description: SAME

Maintenance Agreement Required: ☐ Yes ☑ No

☑ House/Mod. Home No. Bedrooms 3 Garbage Disposal: ~~☐~~ Yes ☑ No

☐ Mobile Home No. Bathrooms 2 Auto. Dishwasher: ☐ Yes ☐ No


☐ Business No. Employees Auto. Washing Machine: ☑ Yes ☐ No

☐ Other Other


☐ Slab ☑ Crawl Space ☐ Basement w/plumbing ☐ Basement wo/plumbing

Comments Follow contour with nitrification field. Footings being poured at time of septic completion.

INITIAL SITE SKETCH

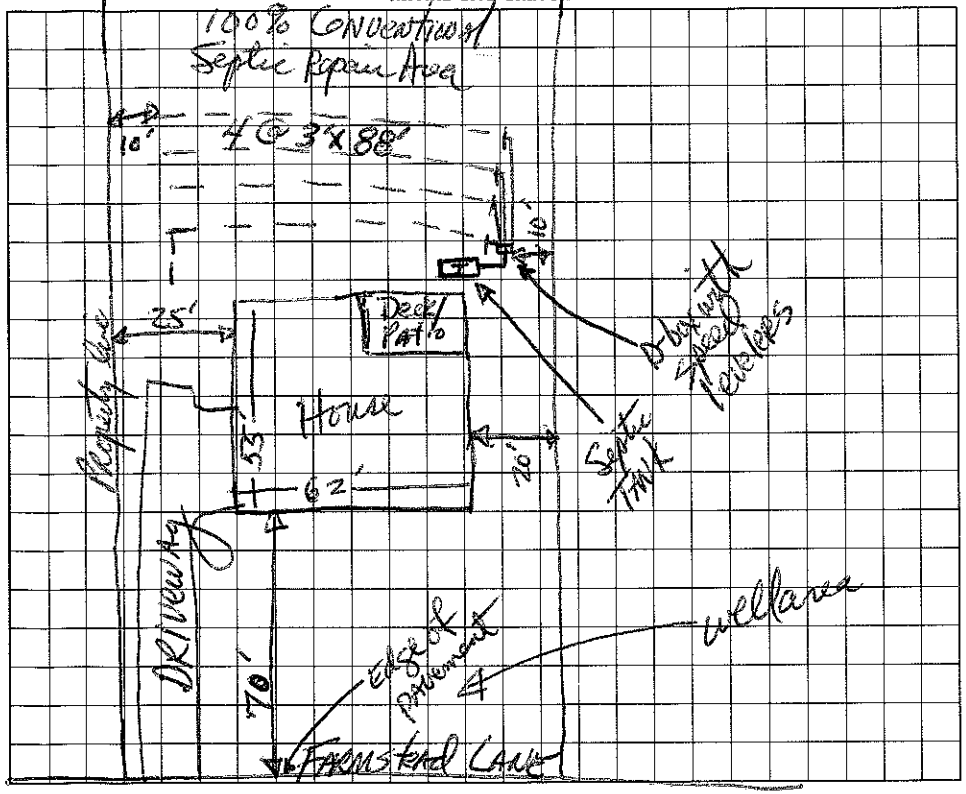

AS BUILT SKETCH

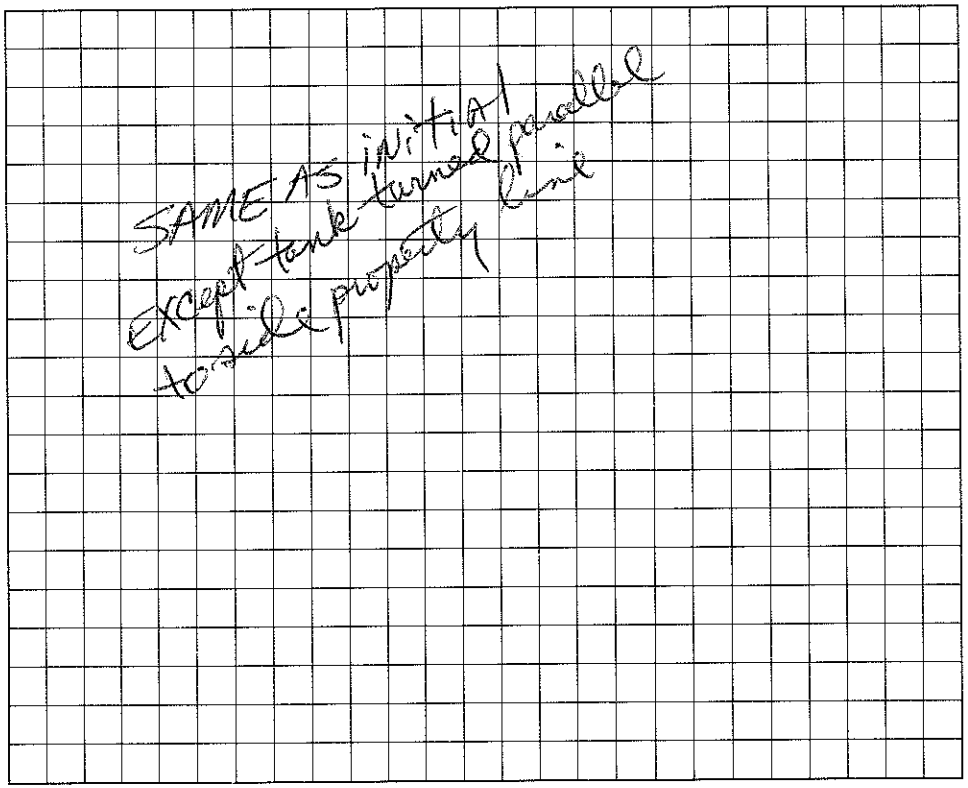

I understand that this permit can be suspended or revoked if any false information is supplied toward securing the permit/any unauthorized changes are made to the site/any unauthorized changes are made in the installation of the system. Improvement Permit is valid for 60 months from date of issuance.

Signed X Catherine Chiarese

Improvement Permit by: David R. Hanson, RS date 6/29/93

Existing System Inspection by: date

Installed by: Donald Galloway A-1 Backhoe

Certificate of Completion by: David R. Hanson, RS date 7/7/93

Operation Permit by: date

HEALTH DEPT. COPY: WHITE INSPECTION COPY (FINAL): GREEN OWNER COPY (FINAL): YELLOW INSPECTION COPY (INITIAL): PINK OWNER COPY (INITIAL): GOLD