IREDELL COUNTY HEALTH DEPARTMENT

STATESVILLE 704-878-5305 125.00 Paid MOORESVILLE 704-664-5281

IMPROVEMENT PERMIT / AUTHORIZATION TO CONSTRUCT / OPERATION PERMIT / EXISTING SYSTEM INSPECTIC

PERMIT# 93280 PIN# 4636 99 7059 DATE 4/6/01

OWNER OR CONTRACTOR GO SMITH DEVELOPMENT / COURTLAND PROP. PHONE: Business 892-0909 Home

ADDRESS PO BOX 908 DAVIDSON / NC 28031

LOCATION BRAWLEY SCHOOL - TL CANVASBACK - TL REGENCY - ON LT

SUBDIVISION REGENCY LAKE BLOCK / SECTION D LOT D 13 LOT AREA .39AC SITE CLASS. PS DESIGN FLOW 360GPD L.T.A.R. .25 gpd/ft²

Septic Tank: 1000 Gallons; STB 794 Date 5/3/02

Pump Tank: Gallons; PT Date

Pump Make: Model Serial No.

Nitrification Field: No Fields 1 Square Feet 500 Linear Feet 250

No Lines 5 @ 50' Trench Width 24" Max Trench Bottom Depth 36" Gravel Depth N/A

☑ New System ☐ Repair System Type: I, II, III, IV, V, VI

System Description: GRAVITY PANEL

Repair System Description: NOT REQUIRED

Maintenance Agreement Required: ☐ Yes ☑ No

☑ House/Mod. Home No. Bedrooms 3

☐ Mobile Home No. Bathrooms 3

☐ Business No. Employees

☐ Other

☐ Slab ☑ Crawl Space ☐ Basement w/plumbing ☐ Basement wo/plumbing


Water Supply: ☐ Individual ☐ Public ☑ Community

Comments:/Conditions:


Comments:/Conditions:

Installed 16" PPBPS

INITIAL SITE SKETCH 1"=50'

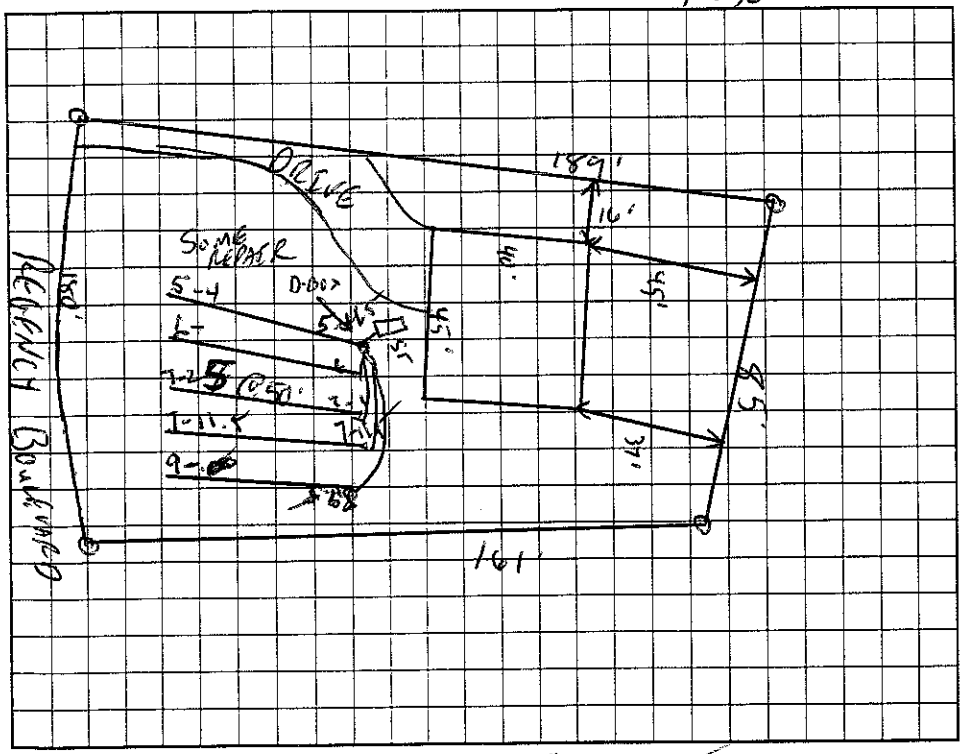

AS BUILT SKETCH

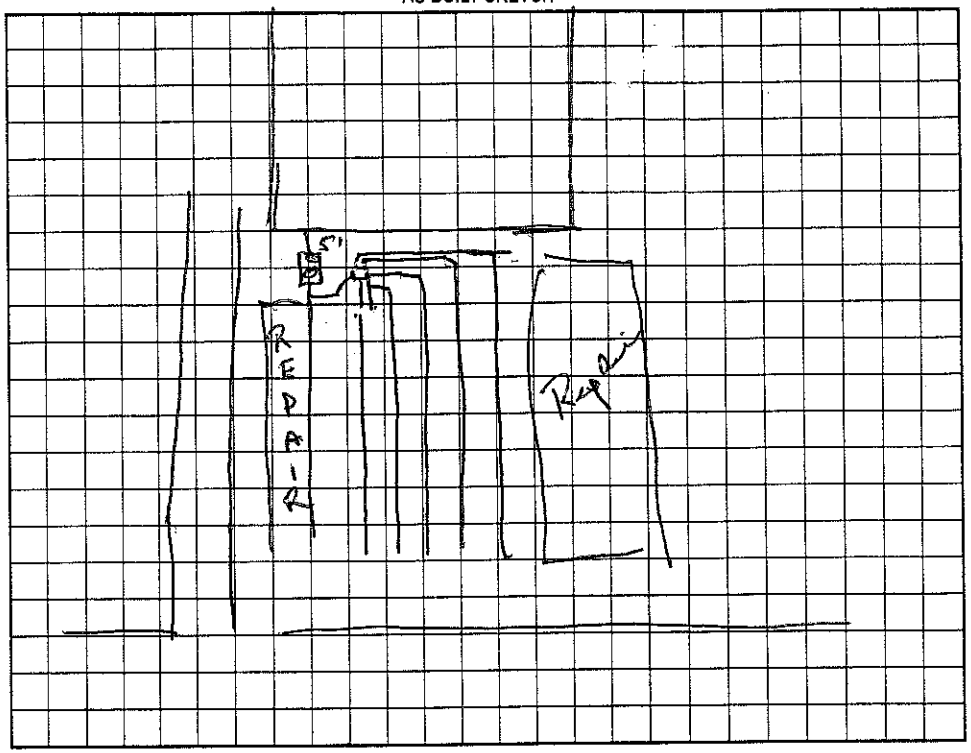

Permit can be suspended or revoked if any false information is supplied toward securing the permit/any unauthorized changes are made to the site/any unauthorized changes are made in the installation of the system. Improvement Permit with plat valid without expiration. Improvement Permit with site plan valid for sixty months. Authorization to Construct is valid for a period equal to that of Improvement Permit – not to exceed sixty months.

Signed: date 5-7-02 Installed by: Jamie Russell

Improvement Permit by: C. Blackburn RS date 4/6/01 Operation Permit by: Wesley Sparkes R.S. date 6/12/02

Authorization to Construct by: C. Blackburn RS date 8/24/01 Existing System Inspection by: date

HEALTH DEPT. COPY: WHITE OWNER COPY (FINAL): YELLOW OWNER COPY (INITIAL): PINK