2:30

IREDELL COUNTY HEALTH DEPARTMENT

STATESVILLE 704-878-5305 $175.00 Paid MOORESVILLE 704-664-5281

IMPROVEMENT PERMIT / AUTHORIZATION TO CONSTRUCT / OPERATION PERMIT / EXISTING SYSTEM INSPECTION

PERMIT# 093282 PIN# 4636997255 DATE 12/10/01

OWNER OR CONTRACTOR G.O. SMITH DEV. PHONE: Business 892-0909 Home

ADDRESS PO BOX 908 DAVIDSON NC 28031

LOCATION BRAWLEY SCHOOL - TL CANVASBACK - TL REGENCY - TL INVERNESS 112 Inverness Loop

SUBDIVISION REGENCY LAKE BLOCK / SECTION D LOT 15 LOT AREA .38AC SITE CLASS. RS DESIGN FLOW 360 GPD L.T.A.R. .36 PD/K=2

Septic Tank: 1000 Gallons; STB Date

Pump Tank: 1000 Gallons; PT Date

Pump Make: Barnes Model EHV412A Serial No. 103542

Nitrification Field: No Fields 1 Square Feet 400 Linear Feet 200

No Lines 4@50' Trench Width 24" Max Trench Bottom Depth 36" Gravel Depth N/A

☑ New System ☐ Repair System Type: I, II, III, IV, V, VI

System Description: PUMP PANEL

Repair System Description: PUMP PANEL

Maintenance Agreement Required: ☐ Yes ☑ No

☑ House/Mod. Home No. Bedrooms 3

☐ Mobile Home No. Bathrooms 3

☐ Business No. Employees

☐ Other


☐ Slab ☑ Crawl Space ☐ Basement w/plumbing ☐ Basement wo/plumbing

Water Supply: ☐ Individual ☐ Public ☑ Community

Comments:/Conditions: Checked elevations on upper 3 lines, checked tanks 3/7/2002 Need to check pipe on upper 2 lines, rope on pump & everything on 4th line.

Comments:/Conditions: Checked pressure 3/7/2002 MD

INITIAL SITE SKETCH 1"=50'

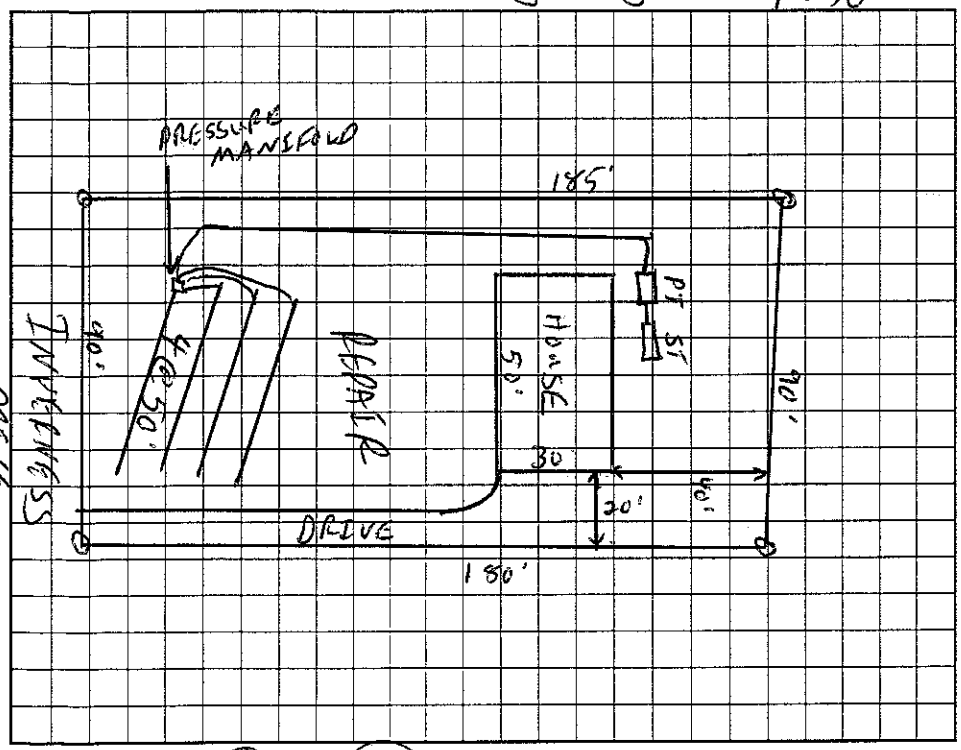

AS BUILT SKETCH

Installed Panel lines

Permit can be suspended or revoked if any false information is supplied toward securing the permit/any unauthorized changes are made to the site/any unauthorized changes are made in the installation of the system. Improvement Permit with plat valid without expiration. Improvement Permit with site plan valid for sixty months. Authorization to Construct is valid for a period equal to that of Improvement Permit – not to exceed sixty months.

Signed: date 12/12/01

Improvement Permit by: RS date 12/10/01

Authorization to Construct by: RS date 12/13/01

Installed by: D.S Myers Co.

Operation Permit by: RS date 5/9/2002

Existing System Inspection by: date

HEALTH DEPT. COPY: WHITE OWNER COPY (FINAL): YELLOW OWNER COPY (INITIAL): PINK