3:30

IREDELL COUNTY HEALTH DEPARTMENT

STATESVILLE 704-878-5305 175.00 Paid MOORESVILLE 704-664-5281

IMPROVEMENT PERMIT / AUTHORIZATION TO CONSTRUCT / OPERATION PERMIT / EXISTING SYSTEM INSPECTION

PERMIT# 093283 PIN# 4636997383 4636-99-7383 DATE 12/10/01

OWNER OR CONTRACTOR GD SMITH DEV. PHONE: Business 892-2909 Home

ADDRESS PO BOX 908 DAVIDSON NC 28031

LOCATION BRAWLEY SCHOOL - TL CANVASBACK - TL REGENCY - TL INVERNESS ON RT

SUBDIVISION REGENCY LAKE BLOCK / SECTION D LOT 16 LOT AREA .39AC SITE CLASS. PS DESIGN FLOW 360GPD L.T.A.R. .36AC/KT 2

Septic Tank: 1000 Gallons; STB 794 Date 4/14/03
Pump Tank: 1000 Gallons; PT 283 Date 3/28/03
Pump Make: L=BERTY Model 1/3 HP Serial No. 15043
Nitrification Field: No Fields 1 Square Feet 400 Linear Feet 200
No Lines 4@50' Trench Width 24" Max Trench Bottom Depth 36" Gravel Depth N/A

☑ New System ☐ Repair System Type: I, II, III, IV, V, VI
System Description: PUMP PANEL
Repair System Description: SAME
Maintenance Agreement Required: ☐ Yes ☑ No

☑ House/Mod. Home No. Bedrooms 3
☐ Mobile Home No. Bathrooms 3
☐ Business No. Employees
☐ Other


☐ Slab ☑ Crawl Space ☐ Basement w/plumbing ☐ Basement wo/plumbing

Water Supply: ☐ Individual ☐ Public ☑ Community


Comments:/Conditions: LABEL FILTER INSTALLED

Comments:/Conditions: DRIVE NOT IN AT INSPECTION

INITIAL SITE SKETCH 1" = 50'

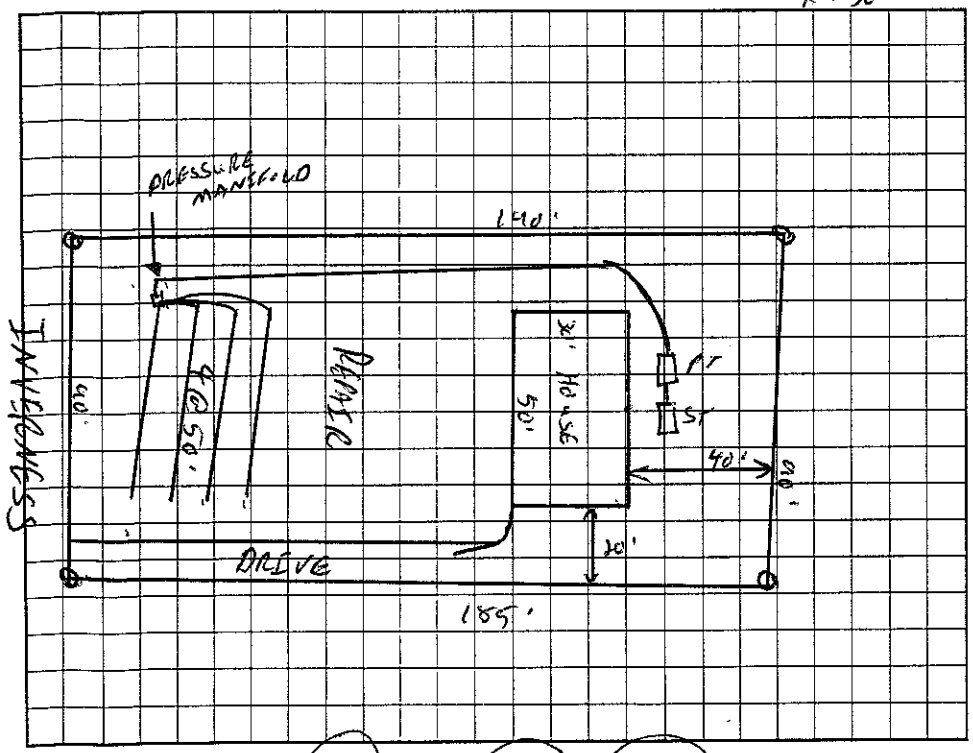

AS BUILT SKETCH

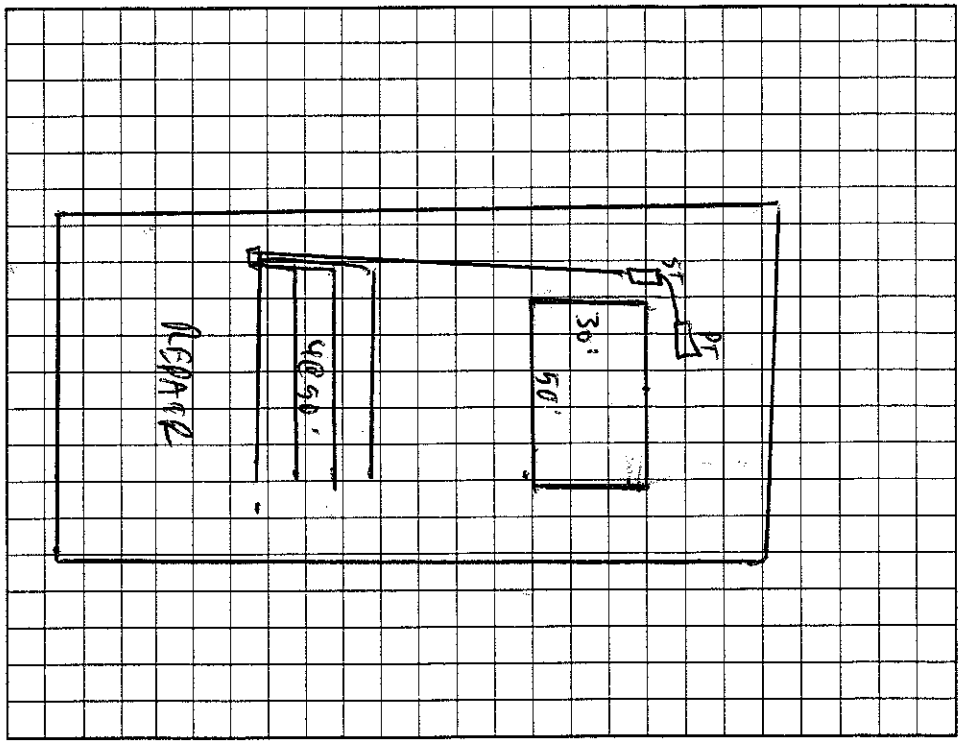

Permit can be suspended or revoked if any false information is supplied toward securing the permit/any unauthorized changes are made to the site/any unauthorized changes are made in the installation of the system. Improvement Permit with plat valid without expiration. Improvement Permit with site plan valid for sixty months. Authorization to Construct is valid for a period equal to that of Improvement Permit – not to exceed sixty months.

Signed: date 12/12/01 Installed by: STANLEY SEPTIC SERVICE

Improvement Permit by: RS date 12/10/01 Operation Permit by: date 5/16/03

Authorization to Construct by: RS date 11/21/02 Existing System Inspection by: date

HEALTH DEPT. COPY: WHITE OWNER COPY (FINAL): YELLOW OWNER COPY (INITIAL): PINK