4636-99-8636

IREDELL COUNTY HEALTH DEPARTMENT

STATESVILLE 704-878-5305 MOORESVILLE 704-664-5281

IMPROVEMENT PERMIT / CERTIFICATE OF COMPLETION / OPERATION PERMIT / EXISTING SYSTEM INSPECTION

~~4:00~~ 4:30

PROPERTY DESCRIPTION NO. 19704 DATE Aug. 2, 194 TAX MAP NO. 2K19A26 Watershed: ☑ Yes ☐ No

OWNER OR CONTRACTOR Richard Stephenson PHONE: Business _____ Home 596-8375

ADDRESS 5120 Tewkesbury Rd. Charlotte 28269

LOCATION 1100 TR just past D46 West II 4TR 1ST Street ~300' on Right

SUBDIVISION Farmstead BLOCK / SECTION _____ LOT 26 LOT AREA 20,000ft² SITE CLASS. PSO DESIGN FLOW 360gpd L.T.A.R. .3

Septic Tank: 1000 Gallons; STB 794 Date 5/13/97

Pump Tank: _____ Gallons; PT _____ Date _____

Pump Make: _____ Model _____ Serial No. _____

Nitrification Field: No Fields 1 Square Feet 1200 Linear Feet 400

No Lines 3-4 Trench Width 36" Max Trench Bottom Depth 36" Gravel Depth 12"

☑ New System ☐ Repair System Type: I, II, III, IV, V, VI

System Description: gravity conventional

Repair System Description: same

Maintenance Agreement Required: ☐ Yes ☑ No

☑ House/Mod. Home No. Bedrooms 3

☐ Mobile Home No. Bathrooms 2

☐ Business No. Employees _____

☐ Other _____


☐ Slab ☑ Crawl Space ☐ Basement w/plumbing ☐ Basement wo/plumbing

Water Supply: ☑ Individual ☐ Community ☐ Public

Comments: follow contour w/ drainfield laterals.

Comments:

INITIAL SITE SKETCH

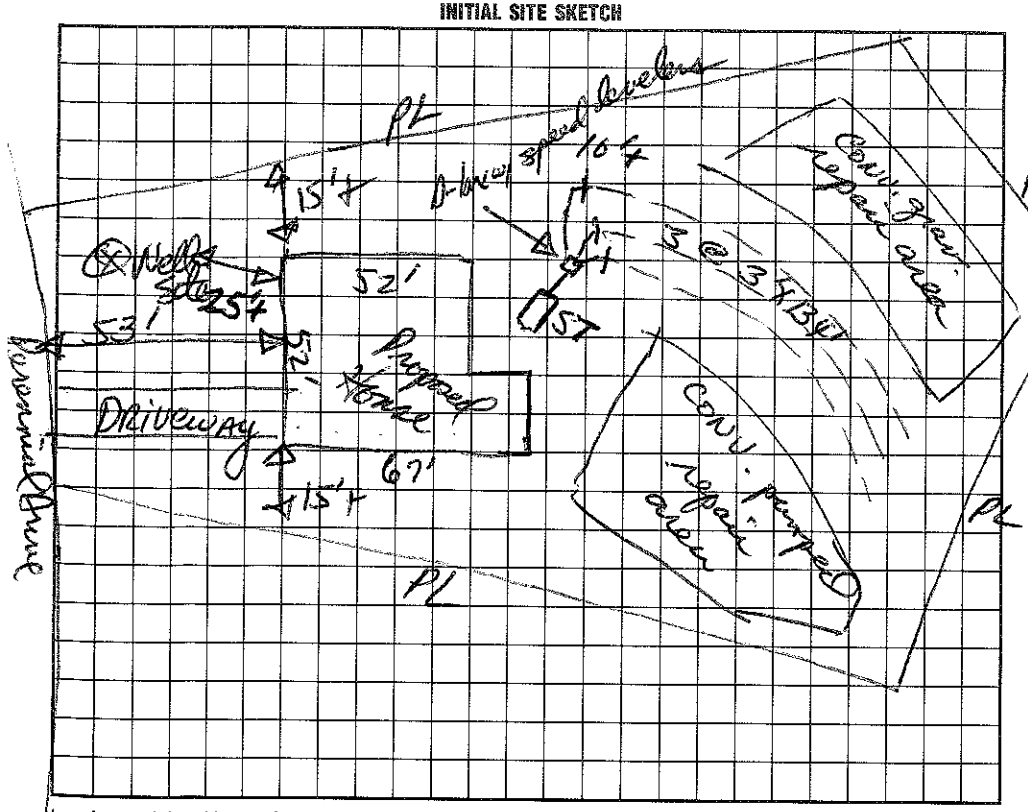

AS BUILT SKETCH

SAME AS SITE SKETCH

I understand that this permit can be suspended or revoked if any false information is supplied toward securing the permit/any unauthorized changes are made to the site/any unauthorized changes are made in the installation of the system. Improvement Permit is valid for 60 months from date of issuance.

Signed: X _____

Improvement Permit by: _____ date 8/2/94

Existing System Inspection by: _____ date _____

Installed by: CURT DUNNING

Certificate of Completion by: _____ date _____

Operation Permit by: _____ date 8/22/97

HEALTH DEPT. COPY: WHITE INSPECTION COPY (FINAL): GREEN OWNER COPY (FINAL): YELLOW INSPECTION COPY (INITIAL): PINK OWNER COPY (INITIAL): GOLD