IREDELL COUNTY HEALTH DEPARTMENT

PIN# 4636-99-8800

4:20 PM

STATESVILLE 704-878-5305 MOORESVILLE 704-664-5281

IMPROVEMENT PERMIT / CERTIFICATE OF COMPLETION / OPERATION PERMIT / EXISTING SYSTEM INSPECTION

PROPERTY DESCRIPTION NO. 21797 DATE 9/5/95 TAX MAP NO. 2K 19 A 27 Watershed: ☒ Yes ☐ No

OWNER OR CONTRACTOR Robert Yoder + Kathy Stapleman PHONE: Business _____ Home _____

ADDRESS 12600 Lefzel Park Pineville NC 28134

LOCATION Perennial Cir on (R) after first brick house

SUBDIVISION Farmstead BLOCK / SECTION _____ LOT 29 LOT AREA 297K/137 SITE CLASS. PS DESIGN FLOW 360 L.T.A.R. .3

Septic Tank: 1000 Gallons; STB 994 Date 10/23/96

Pump Tank: _____ Gallons; PT _____ Date _____

Pump Make: _____ Model _____ Serial No. _____

Nitrification Field: No Fields 1 Square Feet 1200 Linear Feet 400

No Lines 4 Trench Width 36" Max Trench Bottom Depth 36" Gravel Depth 12"

☒ New System ☐ Repair System Type: I, (II), III, IV, V, VI

System Description: Conventional - Dist Box

Repair System Description: Same

Maintenance Agreement Required: ☐ Yes ☒ No

☒ House/Mod. Home No. Bedrooms 3

☐ Mobile Home No. Bathrooms 2

☐ Business No. Employees ____

☐ Other _____


☐ Slab ☒ Crawl Space ☐ Basement w/plumbing ☐ Basement wo/plumbing

Water Supply: ☒ Individual ☐ Community ☐ Public

Comments: On slope contour in direction shown

Comments:

INITIAL SITE SKETCH

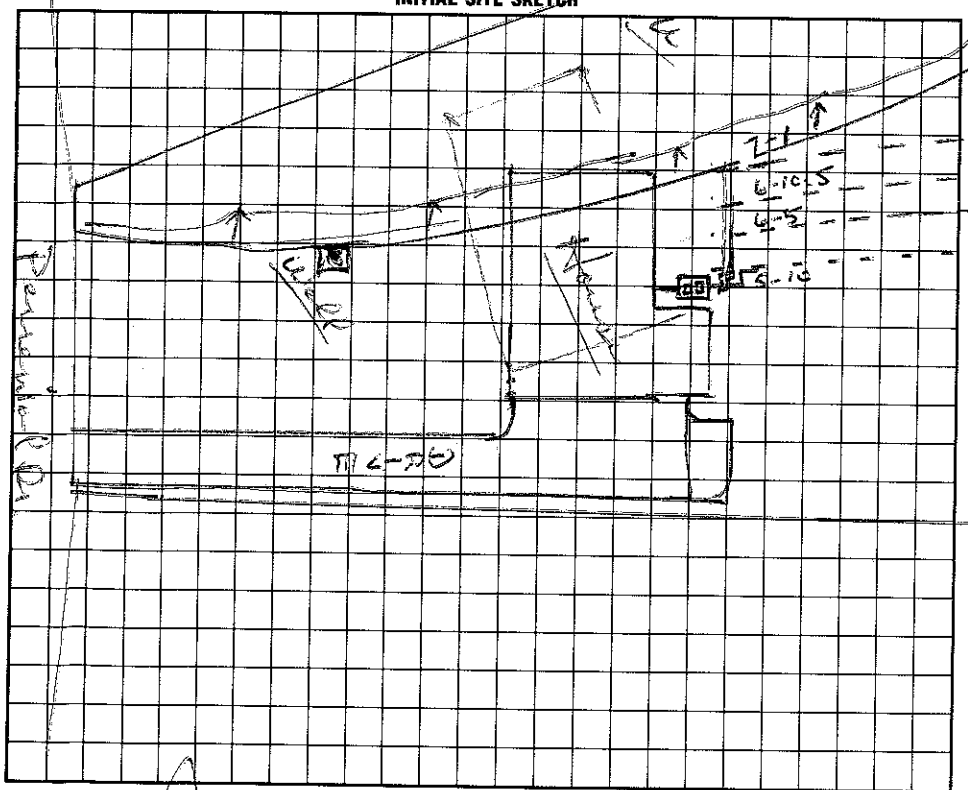

AS BUILT SKETCH

I understand that this permit can be suspended or revoked if any false information is supplied toward securing the permit/any unauthorized changes are made to the site/any unauthorized changes are made in the installation of the system.

Signed: _____

Improvement Permit by: Wesley Sparks RS date 9/5/95

Existing System Inspection by: _____ date _____

Installed by: F J Ervin Const Co.

Certificate of Completion by: Wesley Sparks RS date 1/31/96

Operation Permit by: Wesley Sparks RS date 1/31/96

HEALTH DEPT. COPY: WHITE INSPECTION COPY (FINAL): GREEN OWNER COPY (FINAL): YELLOW INSPECTION COPY (INITIAL): PINK OWNER COPY (INITIAL): GOLD