IREDELL COUNTY HEALTH DEPARTMENT - *ENVIRONMENTAL HEALTH* ☐ STATESVILLE OFFICE 704-878-5305 ☐ MOORESVILLE OFFICE 704-664-5281

IMPROVEMENT PERMIT / AUTHORIZATION TO CONSTRUCT / OPERATION PERMIT / EXISTING SYSTEM INSPECTION

PERMIT # 17259 PIN # 4631699891 3 DATE 5-7-2012

OWNER Cynthia Bowers APPLICANT: Charles Rodden PHONE: Home/Cell # 704 737-3038 Business # 704 663-0856

SITE ADDRESS 108 Perennial Dr. M'ville OWNER / APPLICANT ADDRESS 108 Perennial 704 382-3181

SITE DIRECTIONS Brawley School Rd U turn at Canvasback TR Farmsteead TR Perennial 1st house on Rt.

SUBDIVISION Farmstead Est BLOCK / SECTION _____ LOT # 28 LOT AREA .648Ac DESIGN FLOW 360gpd L.T.A.R. .35

Septic Tank Exist. Gallons: STB _____ Date _____

Pump Tank _____ Gallons: PT _____ Date _____

Pump Make _____ Model _____ Serial # _____

No. Nitrification Fields: 1 No. Lines 4 Linear Feet 300

Trench Width 36" Max. Trench Bottom Depth _____ Gravel Depth ~~Add~~ 12"

☐ ~~New System~~ ☐ Repair ☐ Expansion System Type I (II) III IV V VI

System Description: Existing Gravity - Conventional

Repair System Description: Pump/Grav. Modified Convent.

Maintenance Agreement Required ☐ YES ☒ NO

☒ GRAVITY ☐ PRESSURE


☒ Residence No. Bedrooms 3 ☐ Business No. Persons _____ ☐ Other No. Employees _____ ☐ Slab ☐ Crawl Space ☐ Basement w/plumbing ☐ Basement w/o plumbing

Water Supply: ☒ Private ☐ Public ☐ Community

Comments / Conditions: Existing Septic System "appears" to be functioning okay at time of inspection. The proposed detached garage does not appear to impact Existing Septic System.

★ Must keep any Building at least 25Ft From Well.

INITIAL SITE SKETCH

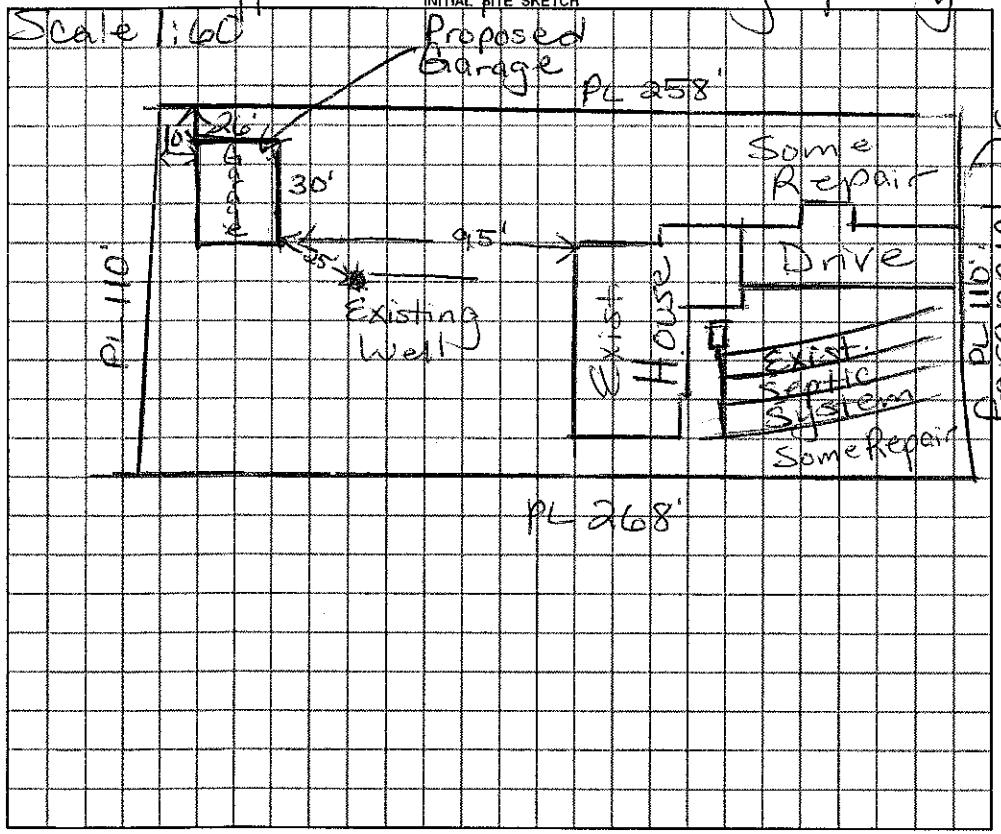

AS BUILT SKETCH

Permit can be suspended or revoked if any false information is supplied toward securing the permit / any unauthorized changes are made to the site / any unauthorized changes are made in the installation of the system.

☐ ***IMPROVEMENT PERMIT*** with plat valid without expiration. ☐ ***IMPROVEMENT PERMIT*** with plat valid ~~without expiration~~ site plan valid 60 mo. ☐ ***AUTHORIZATION TO CONSTRUCT*** valid for period equal to IMPROVEMENT PERMIT--not to exceed 60 mo.

Owner / Applicant Signature: [signature] Date 5-11-12 Installed by: Richard Abernathy 2/2/1993

IMPROVEMENT PERMIT by: _____ ***REHS*** Date _____

AUTHORIZATION TO CONSTRUCT by: _____ ***REHS*** Date _____

OPERATION PERMIT by: _____ ***REHS*** Date _____

Existing System Inspected by: [signature] ***REHS*** Date 5/7/2012

YOU SHOULD CONTACT A LOCATOR SERVICE PRIOR TO ANY EXCAVATION

White Copy – Environmental Health YELLOW COPY (Final) Owner / Applicant PINK COPY (Initial) Owner / Applicant