IREDELL COUNTY HEALTH DEPARTMENT

STATESVILLE 704-878-5305 375.00 R&D MOORESVILLE 704-664-5281 10:00

IMPROVEMENT PERMIT / AUTHORIZATION TO CONSTRUCT / OPERATION PERMIT / EXISTING SYSTEM INSPECTION

PERMIT# 107364 PIN# 4637-90-7712.325 4637-00-0387 DATE Aug 20, 02

OWNER OR CONTRACTOR Shavenders Development Group / Pinnacle Homes PHONE: Business _____ Home _____

ADDRESS 1143-D Executive Dr. Cary N.C 27511

LOCATION Brawley Sch. Rd. TR J Bleume TL Beaver Path TL Cicero TL Shavenders Dr. TL Palmer Marsh TL Archbell Pt on Rt.

SUBDIVISION Shavenders Bluff BLOCK / SECTION 3 LOT 325 LOT AREA .69 Ac SITE CLASS PS DESIGN FLOW 460 gpd L.T.A.R. ~.3

Septic Tank: 1000 Gallons; STB 1012 Date 10-4-02
Pump Tank: 1000 Gallons; PT 17 Date 7-18-03
Pump Make: _____ Model _____ Serial No. _____
Nitrification Field: No Fields 1 Square Feet 600/900 Linear Feet 300
No Lines 4 Trench Width 24" MIN 8'OC Max Trench Bottom Depth 36" 36" MAX 9'OC Gravel Depth NA

☑ New System ☐ Repair System Type: I, II, III, IV, V, VI
System Description: LP PPBPS
Repair System Description: SAME
Maintenance Agreement Required: ☑ Yes ☐ No
☐ Slab ☑ Crawl Space ☐ Basement w/plumbing ☐ Basement wo/plumbing


☑ House/Mod. Home No. Bedrooms 4
☐ Mobile Home No. Bathrooms 4
☐ Business No. Employees _____
☐ Other _____

Water Supply: ☑ Individual ☐ Public ☐ Community

Comments:/Conditions:
Reviewed building plans & site plans 4/3/03; essentially in Compliance with I.P.

Comments:/Conditions: 5/32" hole drilled
17 panels per line
Tanks & lines checked 9/22/03
6" tether

INITIAL SITE SKETCH

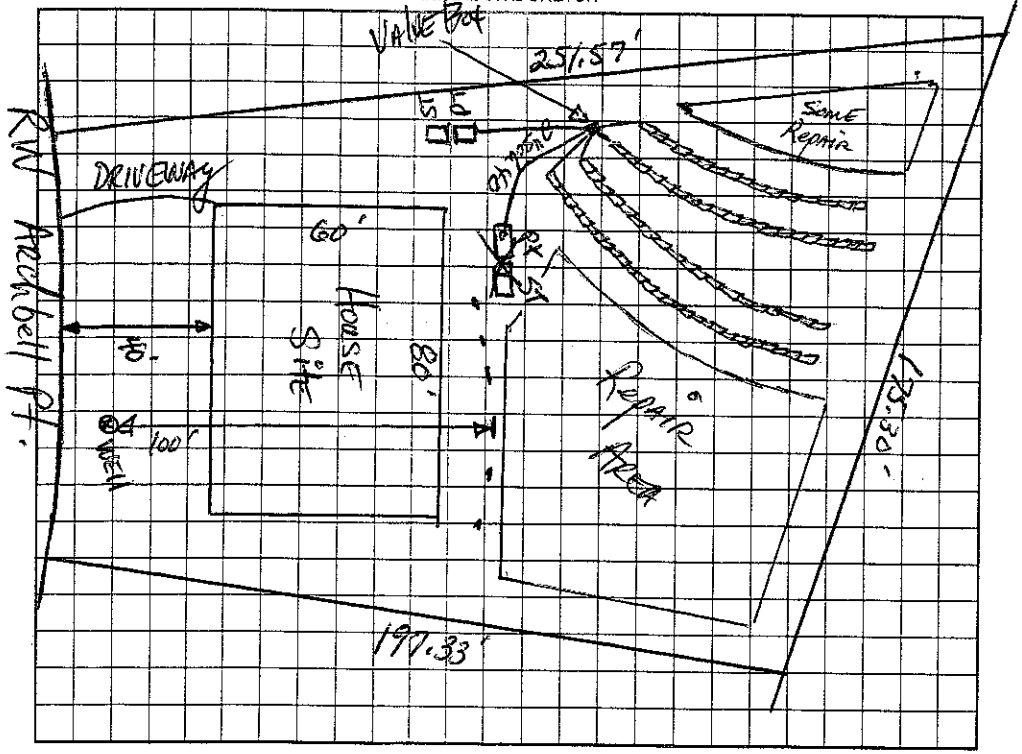

AS BUILT SKETCH

Press., elect. & alarm 10/10/03

Received Maintenance Agreement only - CBF

Permit can be suspended or revoked if any false information is supplied toward securing the permit/any unauthorized changes are made to the site/any unauthorized changes are made in the installation of the system. Improvement Permit with plat valid without expiration. Improvement Permit with site plan valid for sixty months. Authorization to Construct is valid for a period equal to that of Improvement Permit – not to exceed sixty months.

Signed: _____ date 8-29-02 Installed by: Piedmont Backhoe/Steve Jordon

Improvement Permit by: _____ date 8-20-02 Operation Permit by: _____ RS date 10/22/03

Authorization to Construct by: _____ RS date 4/3/03 Existing System Inspection by: _____ date _____

HEALTH DEPT. COPY: WHITE OWNER COPY (FINAL): YELLOW OWNER COPY (INITIAL): PINK