Already Paid $50.00 Redraw 4:00

IREDELL COUNTY HEALTH DEPARTMENT

STATESVILLE 704-878-5305 MOORESVILLE 704-664-5281

IMPROVEMENT PERMIT / AUTHORIZATION TO CONSTRUCT / OPERATION PERMIT / EXISTING SYSTEM INSPECTION

PERMIT# 107366 PIN# 4627907412 3264637-00-1476 DATE 4/24/03

OWNER OR CONTRACTOR E.S. JOHNSON BUILDERS LLC PHONE: Business 704-799-2976 Home 704-896-8865

ADDRESS P.O. Box 1402 CORNELIUS, NC 28031

LOCATION Brawley School Rd TR Blume TL Beaten Path TL Cicero TL Shavenders TL Palmer Marsh TL Archbell on right

SUBDIVISION SHAVENDERS BLUFF BLOCK / SECTION III LOT 326 LOT AREA .69 ACRE SITE CLASS PS DESIGN FLOW 480gpd L.T.A.R. .3

Septic Tank: 1000 Gallons; STB 825 Date 3/15/03
Pump Tank: 1000 Gallons; PT 3.0 Date 4/11/03
Pump Make: Zoeller Model N98-B Serial No.
Nitrification Field: No Fields 1 Square Feet 1200' Linear Feet 400'
No Lines 4@100' Trench Width 36" Max Trench Bottom Depth 36" Gravel Depth N/A

☒ New System ☐ Repair System Type: I, II, III, IV, V, VI
System Description: pump-pm - 25% reduction
Repair System Description: pump-LP - Innovative
Maintenance Agreement Required: ☐ Yes ☐ No


☒ House/Mod. Home No. Bedrooms 4
☐ Mobile Home No. Bathrooms 3
☐ Business No. Employees
☐ Other
☐ Slab ☒ Crawl Space ☐ Basement w/plumbing ☐ Basement wo/plumbing

Water Supply: ☒ Individual ☐ Public ☐ Community

Comments/Conditions: Keep Septic System at least 10' to PL & 100' to Well

Comments/Conditions:

INITIAL SITE SKETCH Scale 1:50

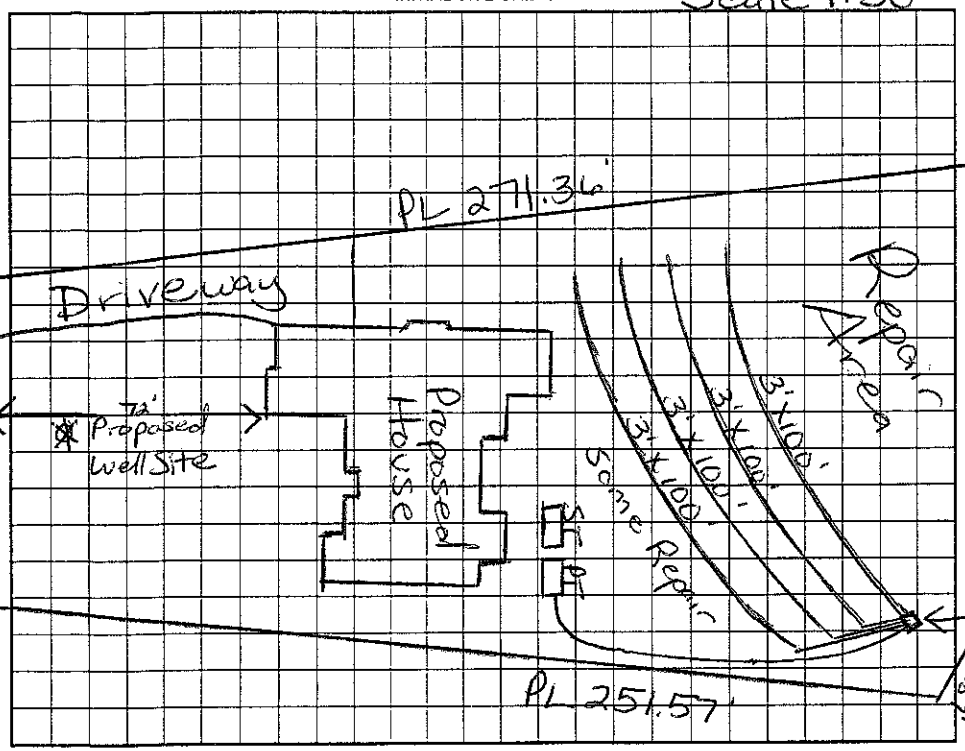

AS BUILT SKETCH

Infiltrators Installed As DRAWN

Permit can be suspended or revoked if any false information is supplied toward securing the permit/any unauthorized changes are made to the site/any unauthorized changes are made in the installation of the system. Improvement Permit with plat valid without expiration. Improvement Permit with site plan valid for sixty months. Authorization to Construct is valid for a period equal to that of Improvement Permit – not to exceed sixty months.

Signed: W. Mc... date 4/25/03 Installed by: Rowan Septic

Improvement Permit by: Maria H. Logan R.S. date 4/24/03 Operation Permit by: R.S. date 11/14/03

Authorization to Construct by: Maria H. Logan R.S. date 4/24/03 Existing System Inspection by: date

HEALTH DEPT. COPY: WHITE OWNER COPY (FINAL): YELLOW OWNER COPY (INITIAL): PINK