IREDELL COUNTY HEALTH DEPARTMENT

4637-00-2517 375.00 Paid COPY

STATESVILLE 704-878-5305 MOORESVILLE 704-664-5281

IMPROVEMENT PERMIT / AUTHORIZATION TO CONSTRUCT / OPERATION PERMIT / EXISTING SYSTEM INSPECTION

PERMIT# 107367 PIN# 4627-90-7412.327 DATE Aug 20, 02

OWNER OR CONTRACTOR Shavender Dev Group Pinnacle Homes (Tom) Drive w/Pinnacle PHONE: Business 361-6662 Home 662-3947

ADDRESS 1143-D Executive DR. Cary, N.C. 27511

LOCATION Brawley Sch Rd. TR Blume TL Beaten Path TL Cicero TL Shavender TL Patterson Marsh TL Archibell #132

SUBDIVISION Shavenders Bluff BLOCK / SECTION 3 LOT 327 LOT AREA .75Ac SITE CLASS. PS DESIGN FLOW 460 gpd L.T.A.R. .25-3 END ON Rt.

Septic Tank: 1000 Gallons: STB 1012 Date 10-26-02

Pump Tank: 1000 Gallons: PT 17 Date 12-29-02

Pump Make: Goulds Model WE05 2HH Serial No. J026 3413

Nitrification Field: No Fields 1 Square Feet 640/960 Linear Feet 320

No Lines 4 Trench Width 24" min 36" Max Trench Bottom Depth 36"

☑ New System ☐ Repair System Type: I, II, III, ☑ V, VI

System Description: LP PPBPS

Repair System Description: SAME

Maintenance Agreement Required: ☑ Yes ☐ No

Gravel Depth N/A

☑ House/Mod. Home ☐ Mobile Home ☐ Business ☐ Other

No. Bedrooms 4 No. Bathrooms 4 No. Employees

☐ Slab ☑ Crawl Space ☐ Basement w/plumbing ☐ Basement wo/plumbing


Water Supply: ☑ Individual ☐ Public ☐ Community

Comments:/Conditions: 36" deep 9' oc

Fill old Road Beds where Low with debris free ps soil.

Comments:/Conditions: Reviewed plans 1/28/03, essentially in compliance with permit. Okay to move tanks into old Road Bed House 50' back from Road

INITIAL SITE SKETCH

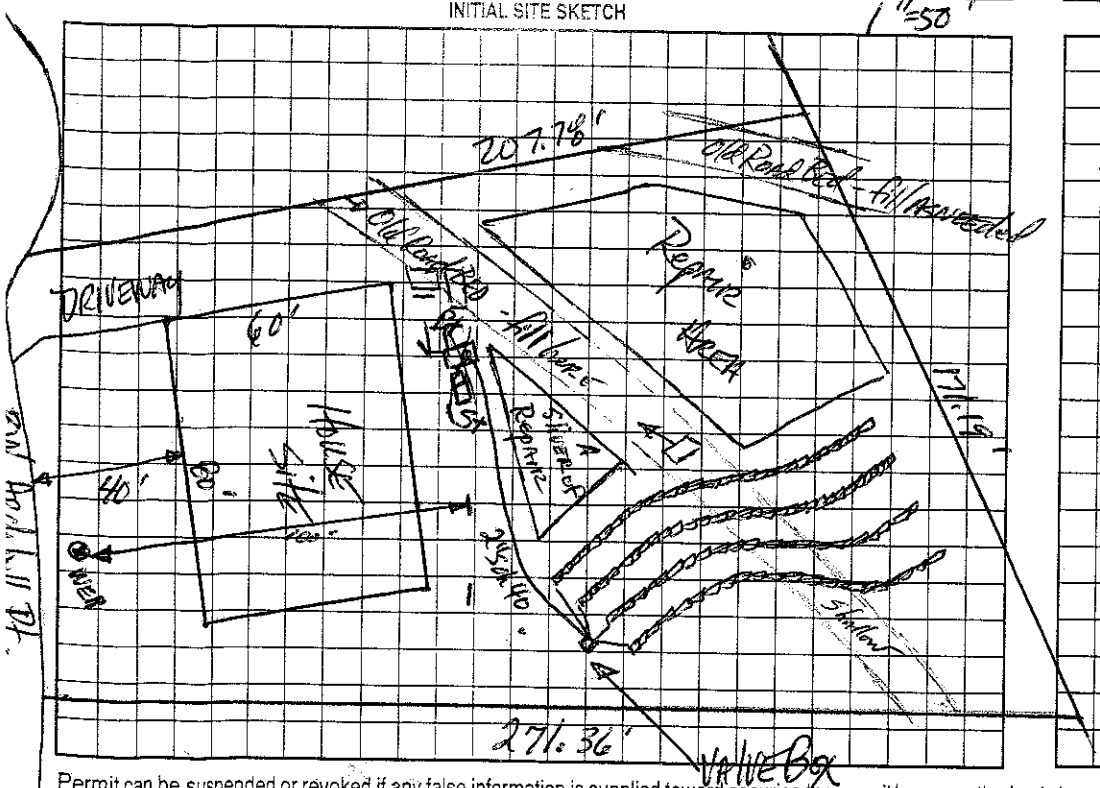

AS BUILT SKETCH

Yellow fitter installed

Lines checked 6/25/03 MS

5/32" hole drilled

18 Panels per ditch = 72 Panels

The proposed / existing DECK addition does not appear to impact the existing septic system.

**NOTE:

REHS

Date: 7-4-03

ICHD-Environmental Health Division

COVERING EX DECK

Permit can be suspended or revoked if any false information is supplied toward securing the permit/any unauthorized changes are made to the site/any unauthorized changes are made in the installation of the system. Improvement Permit with plat valid without expiration. Improvement Permit with site plan valid for sixty months. Authorization to Construct is valid for a period equal to that of Improvement Permit – not to exceed sixty months.

Signed: Joe Fullem date 8-27-02 Installed by: Steve Jordon

Improvement Permit by: Mark Thompson RS date 8-20-02 Operation Permit by: Maria H Dixon RS date 6/26/03

Authorization to Construct by: Maria H Dixon RS date 1/28/03 Existing System Inspection by: date 7/16/03

HEALTH DEPT. COPY: WHITE OWNER COPY (FINAL): YELLOW OWNER COPY (INITIAL): PINK