IREDELL COUNTY HEALTH DEPARTMENT

STATESVILLE 704-878-5305 130.00 Paid MOORESVILLE 704-664-5281

IMPROVEMENT PERMIT / AUTHORIZATION TO CONSTRUCT / OPERATION PERMIT / EXISTING SYSTEM INSPECTION

PERMIT# 10201 PIN# 4637006193 DATE 4/25/05

OWNER OR CONTRACTOR DAVID MARTIN PHONE: Business 201-7690 Home

ADDRESS PO Box 6105 - STATESVILLE NC 28687

LOCATION BRAWLEY School - TR BLUME - TL BEAVER PATH - TL VESTA BLUFF AT END ON RT

SUBDIVISION VESTA BLUFF BLOCK / SECTION 1 LOT 6 LOT AREA 32,791 sf± SITE CLASS. PS DESIGN FLOW 480 L.T.A.R. .3

Septic Tank: 1000 Gallons; STB 794 Date 12/13/05

Pump Tank: Gallons; PT Date

Pump Make: Model Serial No.

Nitrification Field: No Fields 1 Square Feet 1200 Linear Feet 400

No Lines 4 Trench Width 36" Max Trench Bottom Depth 36" Gravel Depth N/A

☑ New System ☐ Repair System Type: I II III IV V VI

System Description: GRAVITY 3 BEDROOM

Repair System Description: LPP PANEL

Maintenance Agreement Required: ☐ Yes ☑ No

☑ House/Mod. Home No. Bedrooms 4

☐ Mobile Home No. Bathrooms 4

☐ Business No. Employees

☐ Other

☐ Slab ☑ Crawl Space ☐ Basement w/plumbing ☐ Basement wo/plumbing

Water Supply: ☑ Individual ☐ Public ☐ Community


Comments:/Conditions:

Proposed Carport

1"=50'

Comments:/Conditions: Infiltration installed

INITIAL SITE SKETCH

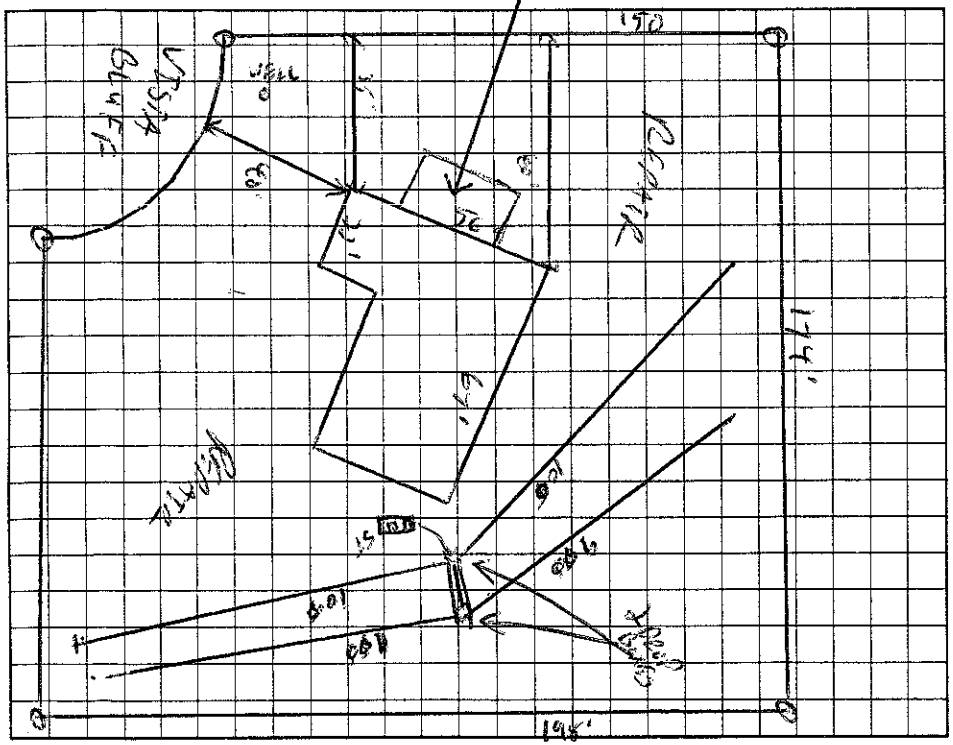

AS BUILT SKETCH

The proposed / existing Carport addition does not appear to impact the existing septic system.

**NOTE:

R.S.

Date: June 21, 2013

ICHD-Environmental Health Division

Permit can be suspended or revoked if any false information is supplied toward securing the permit/any unauthorized changes are made to the site/any unauthorized changes are made in the installation of the system. Improvement Permit with plat valid without expiration. Improvement Permit with site plan valid for sixty months. Authorization to Construct is valid for a period equal to that of Improvement Permit – not to exceed sixty months.

Signed: Julie A Smith date 4/26/05 Installed by: Harry Beaver

Improvement Permit by: C Mac RS date 4/25/05 Operation Permit by: Wendy Sparks RS. date 1/26/05

Authorization to Construct by: C Mac RS date 4/25/05 Existing System Inspection by: date

HEALTH DEPT. COPY: WHITE OWNER COPY (FINAL): YELLOW OWNER COPY (INITIAL): PINK