IREDELL COUNTY HEALTH DEPARTMENT

STATESVILLE 704-878-5305 MOORESVILLE 704-664-5281

IMPROVEMENT PERMIT / AUTHORIZATION TO CONSTRUCT / OPERATION PERMIT / EXISTING SYSTEM INSPECTION

PERMIT # 159768 PIN # 4637006394 DATE 2-10-2010

OWNER or APPLICANT William Leyden Superior Pools PHONE: Business Home:

OWNER or APPLICANT ADDRESS 142 Vista Bluff Mooresville, NC 28117

LOCATION / DIRECTIONS Brawley School Rd TR Blume TL Cypress TL Beaten Path TL Vista Bluff

SUBDIVISION Vista Bluff BLOCK / SECTION LOT # 7 LOT AREA 30,938 DESIGN FLOW 480 L.T.A.R. .3 5th on Rt

Exist

Septic Tank 1000 Gallons: STB Date

Pump Tank 1000 Gallons: P T Date

Pump Make Model Serial #

Nitrification Field No Fields 1 No Lines 4 Linear Feet 280 Ft.

Trench Width Min 24" Existing Max Trench Bottom Depth Gravel Depth N/A ☐ GRAVITY ☒ PRESSURE

☒ New System ☐ Repair ☐ Expansion System Type I II III IV V VI

System Description: Pump-LP-Panel Block

Repair System Description: Same

Maintenance Agreement Required ☒ YES ☐ NO

☒ Residence No. Bedrooms 4

☐ Business No. Persons

☐ Other No. Employees

☐ Slab ☐ Crawl Space


☒ Basement w/plumbing ☐ Basement w/o plumbing

Water Supply: ☒ Private ☐ Public ☐ Community

Comments / Conditions: Existing Septic System appears to be functioning okay at time of inspection. Shady was still covering part of Drainfield

Comments / Conditions: Must keep "pool cut" at least 15 ft from Septic System. Must not cover Drainfield with pool deck. Can not disturb "Repair" areas No heavy equipment on Septic areas

INITIAL SITE SKETCH

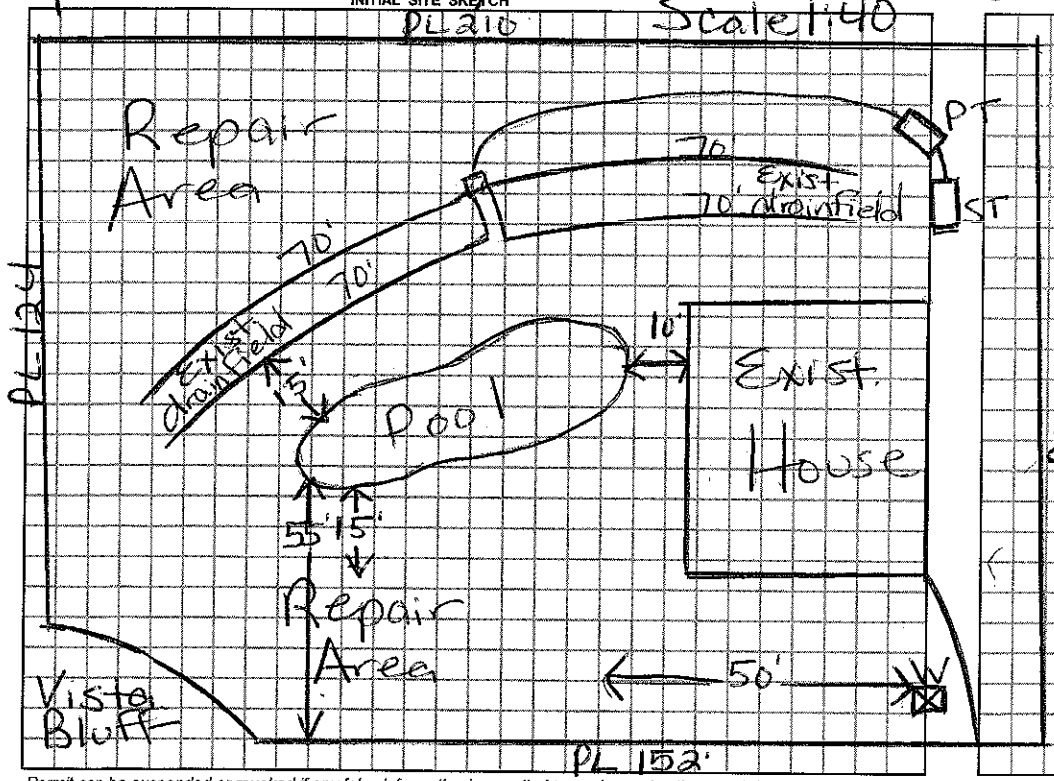

AS BUILT SKETCH

★ Need Current Maint. Agreement with Certified Operator

Permit can be suspended or revoked if any false information is supplied toward securing the permit / any unauthorized changes are made to the site / any unauthorized changes are made in the installation of the system.

☐ IMPROVEMENT PERMIT w/ plat valid without expiration. ☐ IMPROVEMENT PERMIT w / site plan valid for 60 mos. ☐ AUTHORIZATION TO CONSTRUCT valid for period equal to IMPROVEMENT PERMIT-not to exceed 60 mo

Owner / Applicant Signature: Joe Navarro Date 2-12-10

Improvement Permit by: Date

Authorization to Construct by: Date

YOU SHOULD CONTACT A LOCATOR SERVICE PRIOR TO ANY EXCAVATION.

Installed by: Larry Beam Grading (3-8-05)

Operation Permit by: Date:

Existing System Inspected by: Maria Date: REHS

WHITE COPY Environmental Health YELLOW COPY (Final) Owner / Applicant PINK COPY (I