IREDELL COUNTY HEALTH DEPARTMENT

STATESVILLE 704-878-5305 175.00 Paid MOORESVILLE 704-664-5281

IMPROVEMENT PERMIT / AUTHORIZATION TO CONSTRUCT / OPERATION PERMIT / EXISTING SYSTEM INSPECTION

E

PERMIT# 102028 PIN# 4637007594 6594 DATE 10/2/01

OWNER OR CONTRACTOR MOUNTAIN RESOURCES INC PHONE: Business 451 3800 Home

ADDRESS PO BOX 353 TERRELL NC 28682

LOCATION BRAWLEY SCHOOL - TR BLUME · TL BEATEN PATH · TL VISTA BLUFF ON RT

SUBDIVISION VISTA BLUFF BLOCK / SECTION LOT 8 LOT AREA 31760 ft² SITE CLASS. RS DESIGN FLOW 360GPD L.T.A.R. .360 GPD/FT²

Septic Tank: 1000 Gallons; STB 1012 Date 10/27/01
Pump Tank: Gallons; PT Date
Pump Make: Model Serial No.
Nitrification Field: No Fields 1 Square Feet 900 Linear Feet 300
No Lines 4@75' Trench Width 36" Max Trench Bottom Depth 36" Gravel Depth N/A

☑ New System ☐ Repair System Type: I, II, III, IV, V, VI
System Description: GRAVITY 25% REDUCTION
Repair System Description: LP PANEL
Maintenance Agreement Required: ☐ Yes ☑ No


☐ House/Mod. Home No. Bedrooms 3
☐ Mobile Home No. Bathrooms 3
☐ Business No. Employees
☐ Other
☐ Slab ☑ Crawl Space ☐ Basement w/plumbing ☐ Basement wo/plumbing

Water Supply: ☑ Individual ☐ Public ☐ Community


Comments./Conditions:

Comments:/Conditions:

INITIAL SITE SKETCH 1"=50'

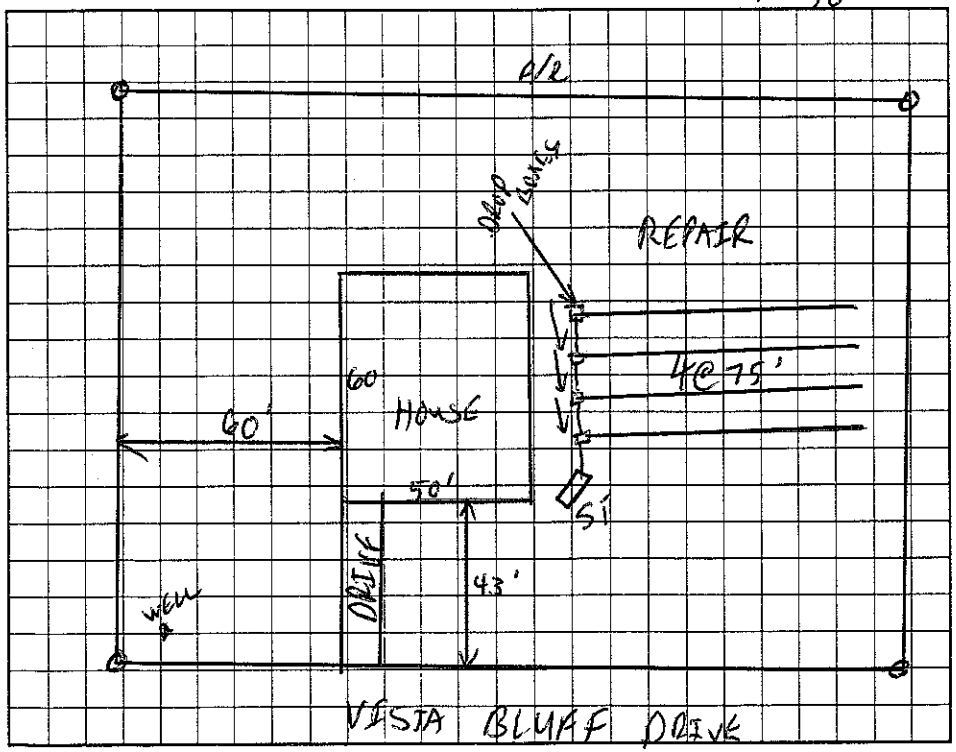

AS BUILT SKETCH

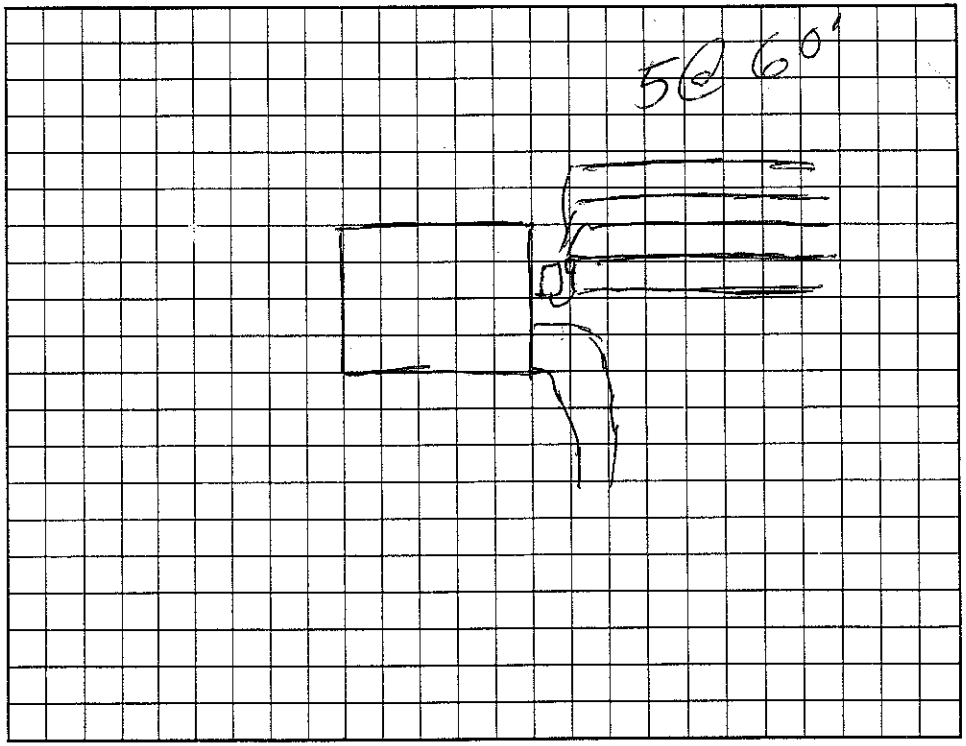

Permit can be suspended or revoked if any false information is supplied toward securing the permit/any unauthorized changes are made to the site/any unauthorized changes are made in the installation of the system. Improvement Permit with plat valid without expiration. Improvement Permit with site plan valid for sixty months. Authorization to Construct is valid for a period equal to that of Improvement Permit – not to exceed sixty months.

Signed: date 10.2.01 Installed by: Richard Abernathy

Improvement Permit by: RS date 10/2/01 Operation Permit by: RS date 3/28/02

Authorization to Construct by: RS date 10/2/01 Existing System Inspection by: date

HEALTH DEPT. COPY: WHITE OWNER COPY (FINAL): YELLOW OWNER COPY (INITIAL): PINK