IREDELL COUNTY HEALTH DEPARTMENT

STATESVILLE 704-878-5305 50.00 Paid MOORESVILLE 704-664-5281

IMPROVEMENT PERMIT / AUTHORIZATION TO CONSTRUCT / OPERATION PERMIT / EXISTING SYSTEM INSPECTION

PERMIT# 102029 PIN# 4637007599706 DATE 9/12/2002

OWNER OR CONTRACTOR Mountain Resources Inc PHONE: Business 400-2924 Cell Home 799-8900

ADDRESS P.O. Box 353 Terrell NC 28682 122 Vista Bluff

LOCATION Brawley School Rd LR Blume TL Beaten Path TL Vista Bluff on Rt

SUBDIVISION Vista Bluff BLOCK / SECTION ____ LOT 9 LOT AREA 31,679 SITE CLASS. RS DESIGN FLOW 480gpd L.T.A.R. .3

Septic Tank: 1000 Gallons; STB 794 Date 1/25/03

Pump Tank: ____ Gallons; PT ____ Date ____

Pump Make: ____ Model ____ Serial No. ____

Nitrification Field: No Fields 1 Square Feet 1200' Linear Feet 400'

No Lines 4@100' Trench Width 36" Max Trench Bottom Depth 36" Gravel Depth N/A

☐ New System ☐ Repair System Type: I, II, III, IV, V, VI

System Description: Gravity - 25% Reduction

Repair System Description: LPP Panel

Maintenance Agreement Required: ☐ Yes ☒ No Not Initially

☒ House/Mod. Home ☐ Mobile Home ☐ Business ☐ Other

No. Bedrooms 4 No. Bathrooms 3½ No. Employees ____


☐ Slab ☒ Crawl Space ☐ Basement w/plumbing ☐ Basement wo/plumbing

Water Supply: ☒ Individual ☐ Public ☐ Community

Comments/Conditions: Keep Septic System at least 10' From PL, 100' to well & 15' from road Cut

Comments/Conditions: EZ FLOW INSTALLED.

INITIAL SITE SKETCH Scale 1:50'

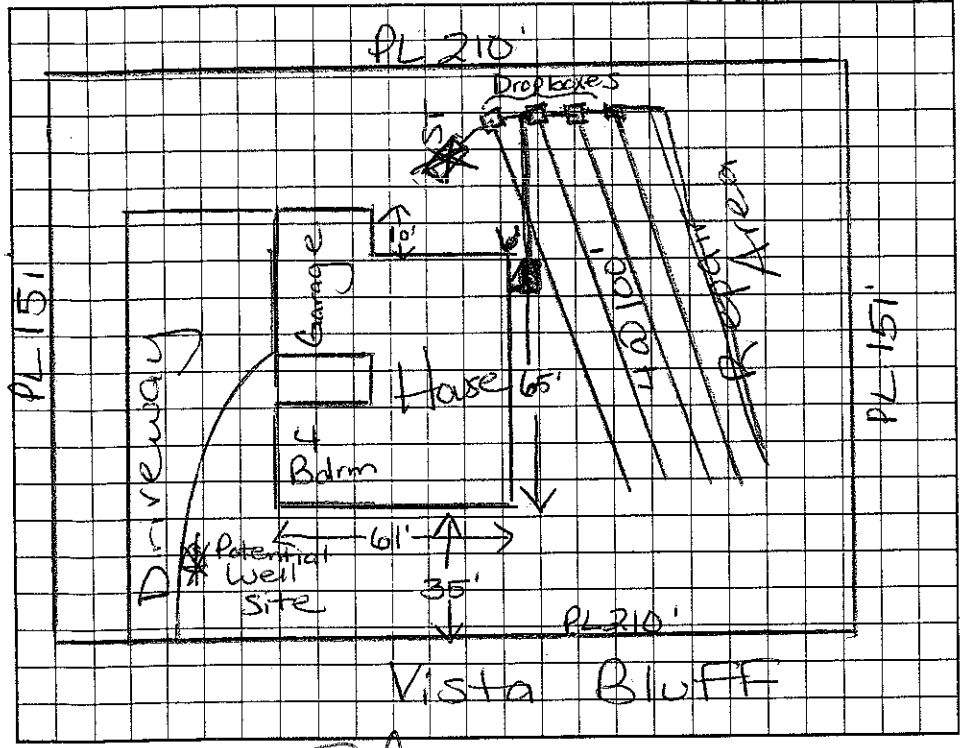

AS BUILT SKETCH

Permit can be suspended or revoked if any false information is supplied toward securing the permit/any unauthorized changes are made to the site/any unauthorized changes are made in the installation of the system. Improvement Permit with plat valid without expiration. Improvement Permit with site plan valid for sixty months. Authorization to Construct is valid for a period equal to that of Improvement Permit – not to exceed sixty months.

Signed: ____ date 9.13.02 Installed by: Larry Beam

Improvement Permit by: Maria H. Dotson RS date 9/12/02 Operation Permit by: Wesley Sparks RS. date 4/22/03

Authorization to Construct by: Maria H. Dotson RS date 9/12/02 Existing System Inspection by: ____ date ____

HEALTH DEPT. COPY: WHITE OWNER COPY (FINAL): YELLOW OWNER COPY (INITIAL): PINK