IREDELL COUNTY HEALTH DEPARTMENT

STATESVILLE 704-878-5305 125.00 Paid MOORESVILLE 704-664-5281

IMPROVEMENT PERMIT / AUTHORIZATION TO CONSTRUCT / OPERATION PERMIT / EXISTING SYSTEM INSPECTION

126950

PERMIT# 102018 PIN# 4637007599.3 4637008594 DATE 1/31/02

OWNER OR CONTRACTOR MOUNTAIN RESOURCE INC. PHONE: Business 541-3500 Home

ADDRESS PO Box 353 TERRELL, NC 28682

LOCATION BRAWLEY SCHOOL - TR BLUME - TL BEATEN PATH - TL VISTA BLUFF - 3RD ON LT

SUBDIVISION VISTA BLUFF BLOCK / SECTION LOT 3 LOT AREA 31280 SITE CLASS PS DESIGN FLOW 360GPD L.T.A.R. .30 PD/FT²

Septic Tank: 1000 Gallons; STB 10RC/10RT/12RT2 Date 1/31/05 1/11/05

Pump Tank: 1000 Gallons; PT Date

Pump Make: Model Serial No.

Nitrification Field: No Fields 1 Square Feet 400 Linear Feet 200

No Lines 4@50' Trench Width 24" Max Trench Bottom Depth 36" Gravel Depth MA

☑ New System ☐ Repair System Type: I, II, III, IV, V, VI

System Description: ~~Pump~~ PANEL

Repair System Description: ~~SCRAP~~ LP PANEL

Maintenance Agreement Required: ☐ Yes ☑ No

☑ House/Mod. Home ☐ Mobile Home ☐ Business ☐ Other

No. Bedrooms 3 No. Bathrooms 3 No. Employees

☐ Slab ☐ Crawl Space ☑ Basement w/plumbing ☐ Basement wo/plumbing


Water Supply: ☑ Individual ☐ Public ☐ Community

Comments:/Conditions:

Comments:/Conditions:

PPBPS installed on shop brakes

INITIAL SITE SKETCH 1"=50'

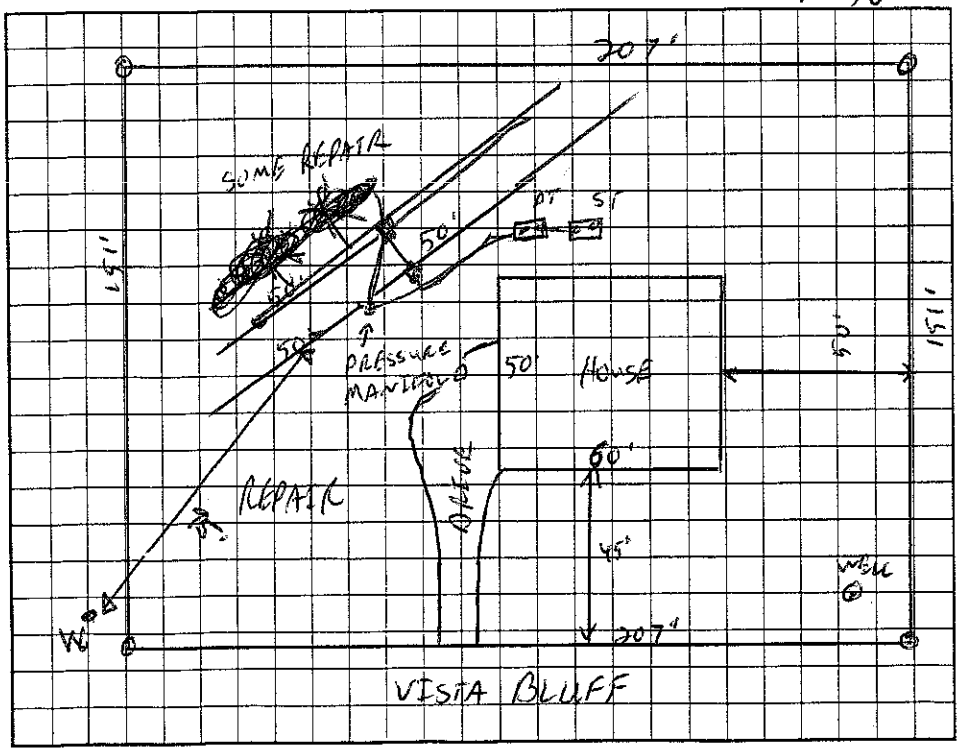

AS BUILT SKETCH

Permit can be suspended or revoked if any false information is supplied toward securing the permit/any unauthorized changes are made to the site/any unauthorized changes are made in the installation of the system. Improvement Permit with plat valid without expiration. Improvement Permit with site plan valid for sixty months. Authorization to Construct is valid for a period equal to that of Improvement Permit – not to exceed sixty months.

Signed: date 6.18.02 Installed by: Fryar Grading

Improvement Permit by: C. Rose RS date 1/31/02 Operation Permit by: Wesley Sparkman RS date 7/13/05

Authorization to Construct by: C. Rose RS date 1/31/02 Existing System Inspection by: date

HEALTH DEPT. COPY: WHITE OWNER COPY (FINAL): YELLOW OWNER COPY (INITIAL): PINK