FJ Ervin - 1.30 2.00 - 175

IREDELL COUNTY HEALTH DEPARTMENT

STATESVILLE 704-878-5305 MOORESVILLE 704-664-5281

IMPROVEMENT PERMIT / AUTHORIZATION TO CONSTRUCT / OPERATION PERMIT / EXISTING SYSTEM INSPECTION

PERMIT# 070872 PIN# 4637011156 DATE 1/27/98

OWNER OR CONTRACTOR SHAVENDER'S DEV. GROUP PHONE: Business 663-6905 T JACOBS Home

ADDRESS 1143-D EXECUTIVE CIRCLE CARY NC 28511

LOCATION BRAWLEY SCHOOL RD - TR BLUME - TL BEATEN PATH - ON LT

SUBDIVISION SHAVENDER'S BLUFF BLOCK / SECTION 1 LOT 14 LOT AREA 1.74 AC SITE CLASS. RS DESIGN FLOW 360 GPD L.T.A.R. .3000 / FS

Septic Tank: 1060 Gallons; STB 794 Date 10/27/00
Pump Tank: 1000 Gallons; PT 283 Date 11/7/00
Pump Make: GOULDS Model WE0-311M Serial No. K00428824
Nitrification Field: No Fields 1 Square Feet 400 Linear Feet 200
No Lines 3 Trench Width 24" Max Trench Bottom Depth 30" Gravel Depth N/A

☑ New System ☐ Repair System Type: I, II, III, IV, V, VI
System Description: PUMP PANEL
Repair System Description: SAME
Maintenance Agreement Required: ☑ Yes ☐ No

☑ House/Mod. Home No. Bedrooms 3
☐ Mobile Home No. Bathrooms 3
☐ Business No. Employees
☐ Other

☐ Slab ☑ Crawl Space ☐ Basement w/plumbing ☐ Basement wo/plumbing


Water Supply: ☑ Individual ☐ Public ☐ Community

Comments:/Conditions:


Comments:/Conditions: 12/22/00 - Tanks, Lines, Tether Checked

1" = 40'

INITIAL SITE SKETCH

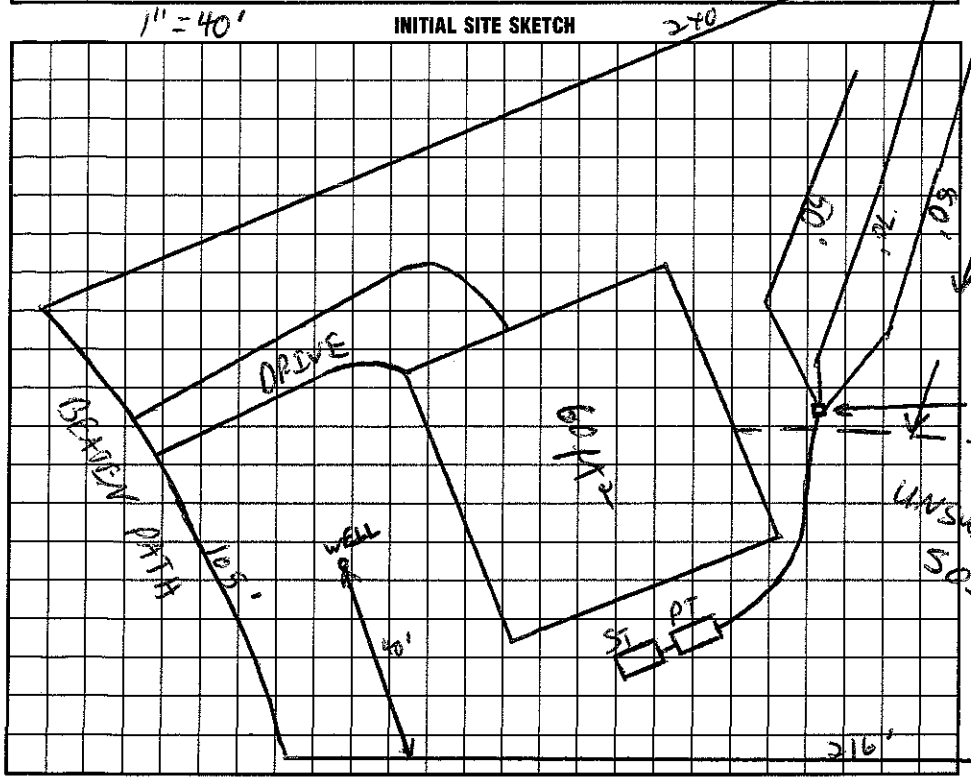

AS BUILT SKETCH

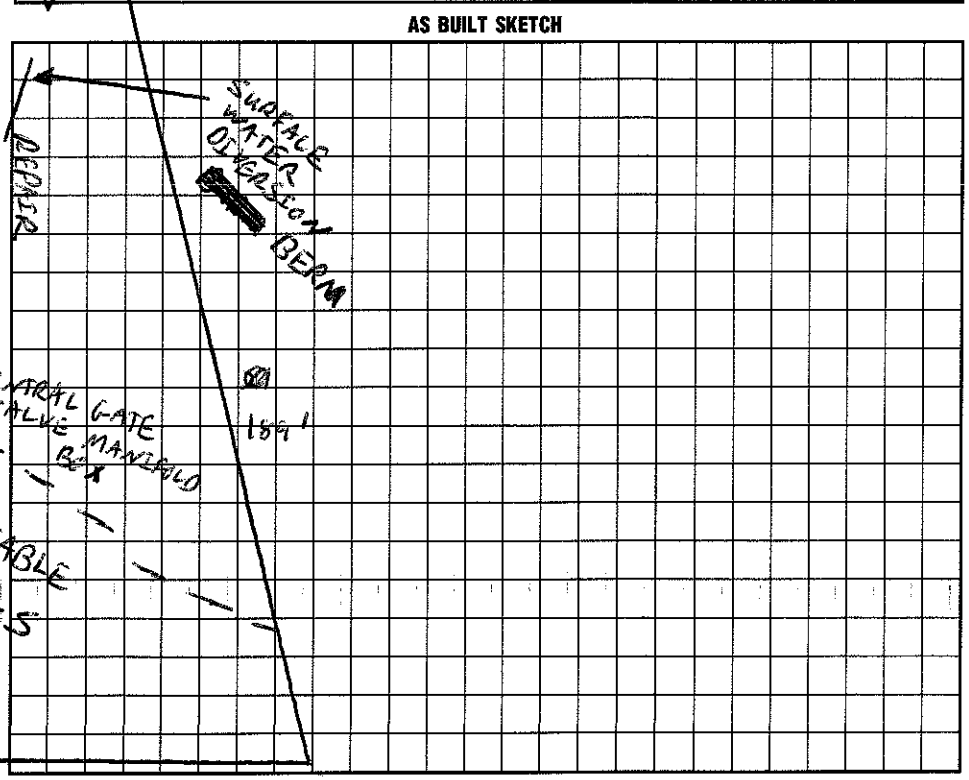

I understand that this permit can be suspended or revoked if any false information is supplied toward securing the permit/any unauthorized changes are made to the site/any unauthorized changes are made in the installation of the system. Improvement Permit with plat valid without expiration. Improvement Permit with site plan valid for sixty months. Authorization to Construct is valid for a period equal to that of Improvement Permit – not to exceed sixty months.

Signed: Agent date 2/4/98

Improvement Permit by: RS date 1/27/98

Authorization to Construct by: RS date 6/12/00

Installed by: FJ Ervin

Operation Permit by: RS date 12/29/00

Existing System Inspection by: date

HEALTH DEPT. COPY: WHITE INSPECTION COPY (FINAL): GREEN OWNER COPY (FINAL): YELLOW INSPECTION COPY (INITIAL): PINK OWNER COPY (INITIAL): GOLD