IREDELL COUNTY HEALTH DEPARTMENT

Authorization to Construct — Misc.

STATESVILLE 704-878-5305 — MOORESVILLE 704-664-5281

IMPROVEMENT PERMIT / ~~CERTIFICATE OF COMPLETION~~ / OPERATION PERMIT / EXISTING SYSTEM INSPECTION

PROPERTY DESCRIPTION NO. 22384 DATE 6/27/97 TAX MAP NO. 2L A 20 4637 01 8405 Watershed: X Yes ☐ No

OWNER OR CONTRACTOR W B Raynor Jr. PHONE: Business Home 873-7285

ADDRESS 1031 Valley St. Statesville, NC 28677

LOCATION Brawley Sch TR Blume TL Beaten Path TR # 188 to house 188 Beaten Path Rd

SUBDIVISION ? C L + T BLOCK / SECTION LOT LOT AREA SITE CLASS. PS DESIGN FLOW 360 L.T.A.R. .3

Septic Tank: 1000 Gallons; STB 794 Date 2/25/99

Pump Tank: 1000 Gallons; PT 27 Date 1/12/99

Pump Make: Hydromatic Model SHEF50A1 Serial No. 5/99

Nitrification Field: No Fields 1 Square Feet ~~410~~ Linear Feet ~~205~~

No Lines 4 Trench Width 24" Max Trench Bottom Depth 36" Gravel Depth SAND

X New System ☐ Repair System Type: I, II, (III), IV, V, VI

System Description: PressMan — 1½" APBS

Repair System Description: SAME

Maintenance Agreement Required: ☐ Yes X No

X House/Mod. Home No. Bedrooms 3

☐ Mobile Home No. Bathrooms 3

☐ Business No. Employees

☐ Other

X Slab ☐ Crawl Space ☐ Basement w/plumbing ☐ Basement wo/plumbing


Water Supply: X Individual ☐ Community ☐ Public

Comments:


Comments:

5.7 Drawdown - 115 GPM base

INITIAL SITE SKETCH

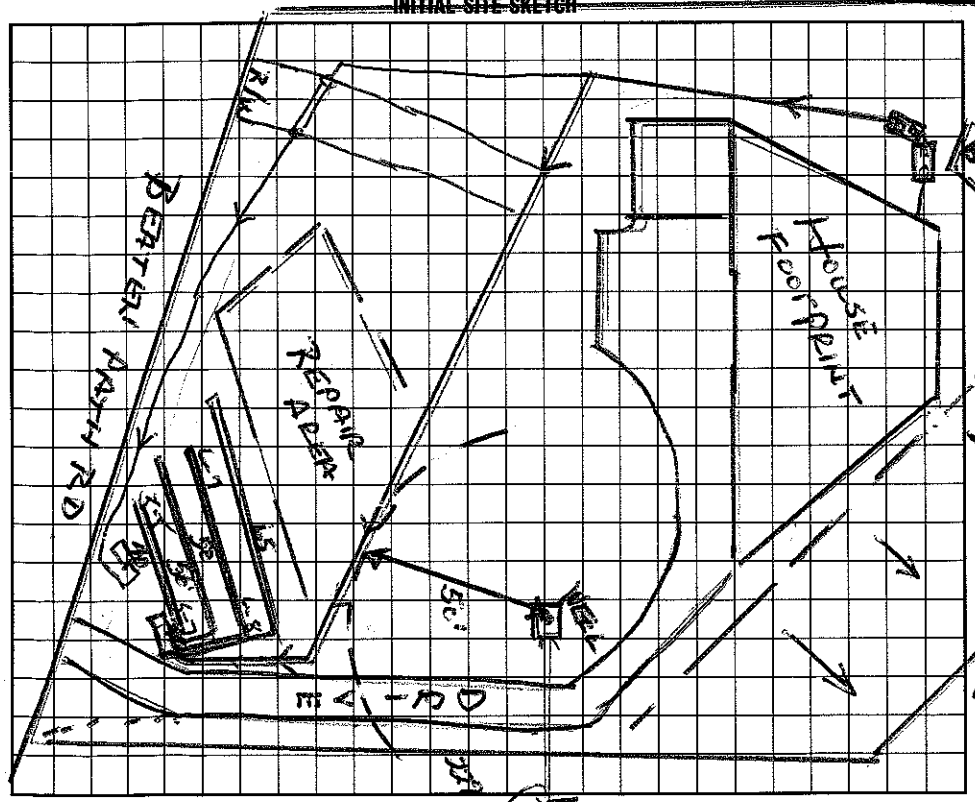

AS BUILT SKETCH

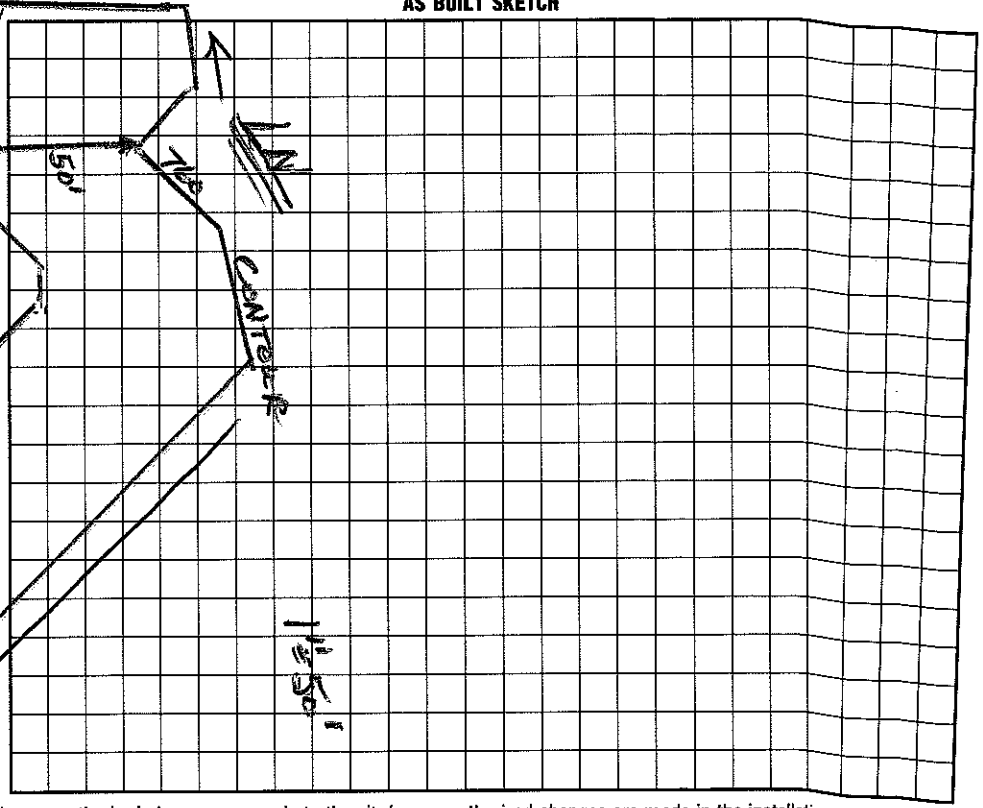

I understand that this permit can be suspended or revoked if any false information is supplied toward securing the permit/any unauthorized changes are made to the site/any unauthorized changes are made in the installation of the system. Improvement Permit is valid for 60 months from date of issuance.

Signed: X

Improvement Permit by: Wesley Sparks RS. date 6/27/97

Existing System Inspection by: Wesley Sparks RS date 6/27/97

Installed by: James Huddleston

Certificate of Completion by: Wesley Sparks RS. date 9/23/99

Operation Permit by: Wesley Sparks RS date 9/23/99

HEALTH DEPT. COPY: WHITE — INSPECTION COPY (FINAL): GREEN — OWNER COPY (FINAL): YELLOW — INSPECTION COPY (INITIAL): PINK — OWNER COPY (INITIAL): GOLD