IREDELL COUNTY HEALTH DEPARTMENT

STATESVILLE 704-878-5305 MOORESVILLE 704-664-5281

IMPROVEMENT PERMIT / AUTHORIZATION TO CONSTRUCT / OPERATION PERMIT / EXISTING SYSTEM INSPECTION

PERMIT# 130829 PIN# 4637-11-0119.002 4637-01-9284 DATE 5/24/06

OWNER OR APPLICANT Bo of NC, Inc. PHONE: Business _____ Home _____

ADDRESS 349 Williamson Rd Ste 101 Mooresville NC 28117

LOCATION 3 SR, TR Blume, TL Beaten Path, on Rt

SUBDIVISION _____ BLOCK / SECTION _____ LOT 2 LOT AREA 0.532 ac SITE CLASS. PS DESIGN FLOW 480 L.T.A.R. 0.3

Septic Tank: 1000 Gallons; STB 786 Date 3-21-06
Pump Tank: 1000 Gallons; PT 32 Date 3-21-06
Pump Make: ZOELLER Model N-140 Serial No. 5206
Nitrification Field: No Fields 1 Square Feet 534 Linear Feet 267
No Lines 5 Trench Width 24" Max Trench Bottom Depth 56" Gravel Depth — ☐ Gravity ☒ Pressure

☒ New System ☐ Repair ☐ Expansion System Type: I II III IV V VI
System Description: LP Panel Block
Repair System Description: None
Maintenance Agreement Required: ☒ Yes ☐ No

☒ House/Mod. Home No. Bedrooms 4
☐ Mobile Home No. Persons ____
☐ Business No. Employees ____
☐ Other _____


Water Supply: ☐ Individual ☐ Public ☐ Community

☐ Slab ☐ Crawl Space ☒ Basement w/plumbing ☐ Basement wo/plumbing


Comments:/Conditions:

Comments:/Conditions:

INITIAL SITE SKETCH

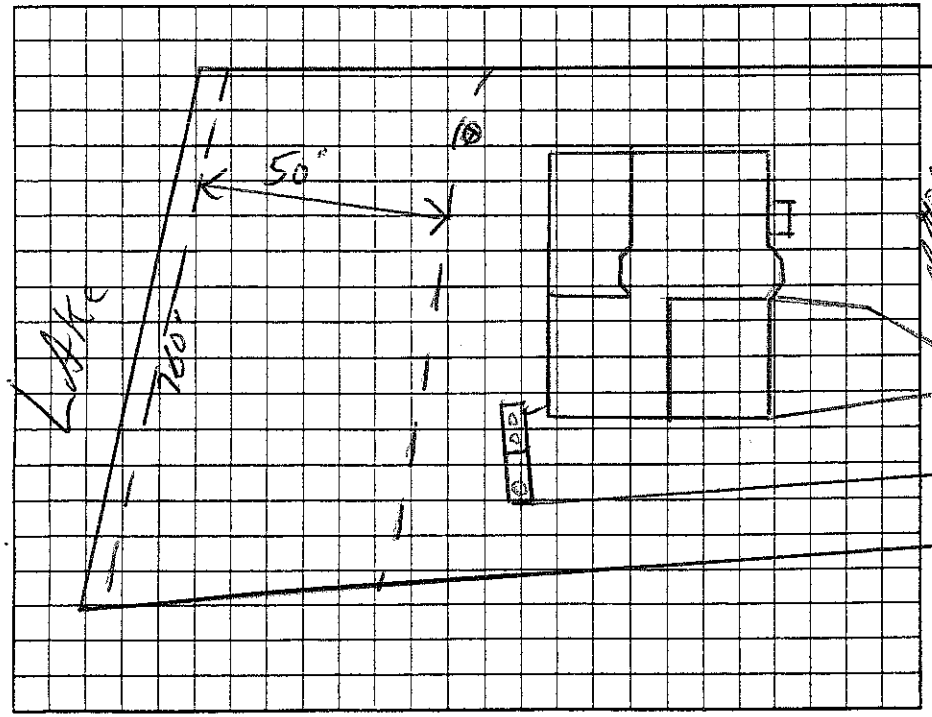

AS BUILT SKETCH

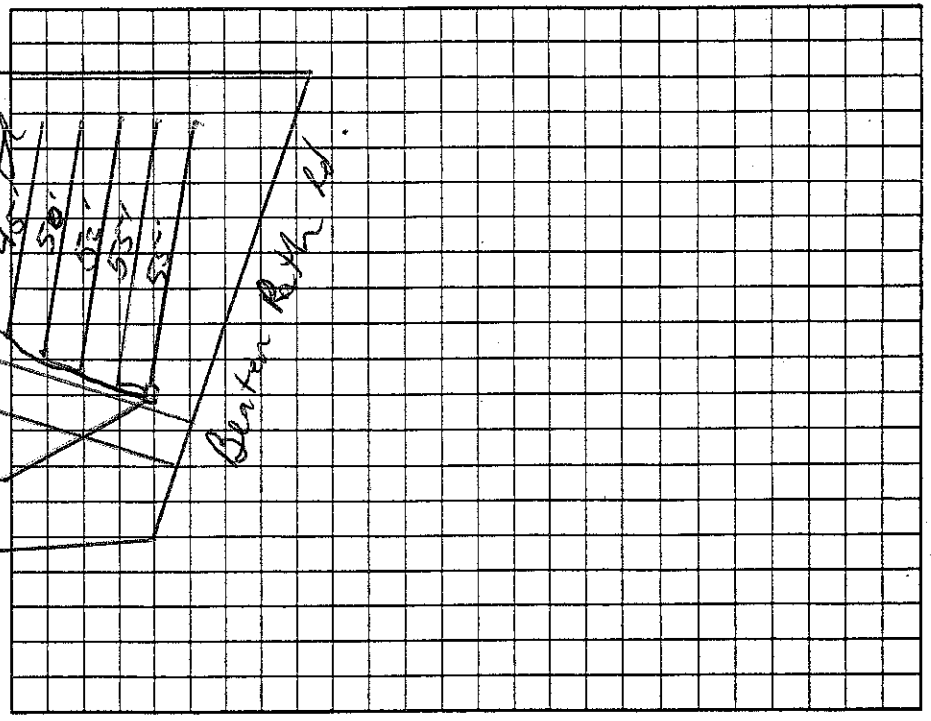

Permit can be suspended or revoked if any false information is supplied toward securing the permit/any unauthorized changes are made to the site/any unauthorized changes are made in the installation of the system. Improvement Permit with plat valid without expiration ☐ Improvement Permit with site plan valid for sixty months ☐ Authorization to Construct is valid for a period equal to that of Improvement Permit – not to exceed sixty months.

Signed: Elaine Laidlaw date 5-24-06 Installed by: G+M Construction

Improvement Permit by: RS date 5/24/06 Operation Permit by: Wesley Sparks RS. date 8/8/06

Authorization to Construct by: RS date 5/24/06 Existing System Inspection by: _____ date _____

HEALTH DEPT. COPY: WHITE OWNER COPY (FINAL): YELLOW OWNER COPY (INITIAL): PINK