IREDELL COUNTY HEALTH DEPARTMENT

Statesville Phone TR 3-7271 Mooresville Phone NO 3-1271

PERMIT TO INSTALL SEPTIC TANK

Permit NO. Cont. Permit Date Aug 28 1964

Ronnie Kiser. Address Charlotte, N.C.

Installed By M.C. Laurin Address Huntersville N.C


Location of Property Section 9 Lot #109

Tank		Capacity		Length of Lines		Fixtures	
Block	( )	800	( )	150'	( )	No. of Baths	( )
Precast	(X)	900	( )	175'	( )	Dishwasher	( )
		1000	(X)	200'	( )	Garbage Grdr.	( )
		1100	( )	225'	(X)	Auto-Washer	( )
		1200	( )	250'	( )	Other	
		Other		Other			

NOTIFY HEALTH DEPARTMENT AT LEAST EIGHT HOURS BEFORE TANK IS TO BE INSPECTED.

Final Inspection Aug 28 1964 Approved (X) Disapproved ( )

Remarks

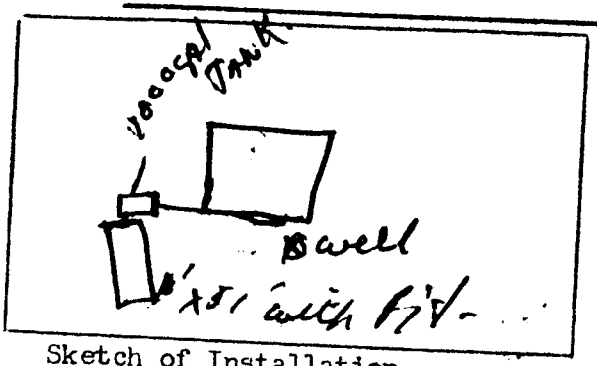

Sketch of Installation

Ray K. Livingston RS

Sanitarian