4637028587

IREDELL COUNTY HEALTH DEPARTMENT

STATESVILLE 704-878-5305 MOORESVILLE 704-664-5281

IMPROVEMENT PERMIT / CERTIFICATE OF COMPLETION / OPERATION PERMIT / EXISTING SYSTEM INSPECTION

PROPERTY DESCRIPTION NO. 18024 DATE April 4, 194 TAX MAP NO. 2L5A 138 Watershed: ☑ Yes ☐ No

OWNER OR CONTRACTOR MARVIN Ridings PHONE: Business Home 664-7744 L.N.

ADDRESS Rt 9, Box 174 Mooresville

LOCATION 1100 TR 1178 (Blume Rd.) to End TL Culpeza ~ 1/10 mile on Right

SUBDIVISION Crescent LN BLOCK / SECTION 9 LOT 138 LOT AREA 20,000 ft±2 SITE CLASS. DESIGN FLOW 360 gpd. L.T.A.R. .3

Septic Tank: 1000 Gallons; STB 825 ST Date 8-4-94

Pump Tank: Gallons; PT Date

Pump Make: Model Serial No.

Nitrification Field: No Fields 1 Square Feet 1200 Linear Feet 400

No Lines 3 Trench Width 36" Max Trench Bottom Depth 36" Gravel Depth 12"

☑ New System ☐ Repair System Type: I, II, III, IV, V, VI

System Description: gravity CONVENTIONAL

Repair System Description: LAPPBPS

Maintenance Agreement Required: ☐ Yes ☑ No

☑ House/Mod. Home No. Bedrooms 3

☐ Mobile Home No. Bathrooms 3.5

☐ Business No. Employees

☐ Other


☐ Slab ☐ Crawl Space ☑ Basement w/plumbing ☐ Basement wo/plumbing

Water Supply: ☑ Individual EX. ☐ Community ☐ Public


Comments: Existing lot recorded prior to 1983. Little if any repair area will remain. Repair may involve well abandonment. Install new nitrification laterals at 36" trench bottom depth.

Comments:

INITIAL SITE SKETCH

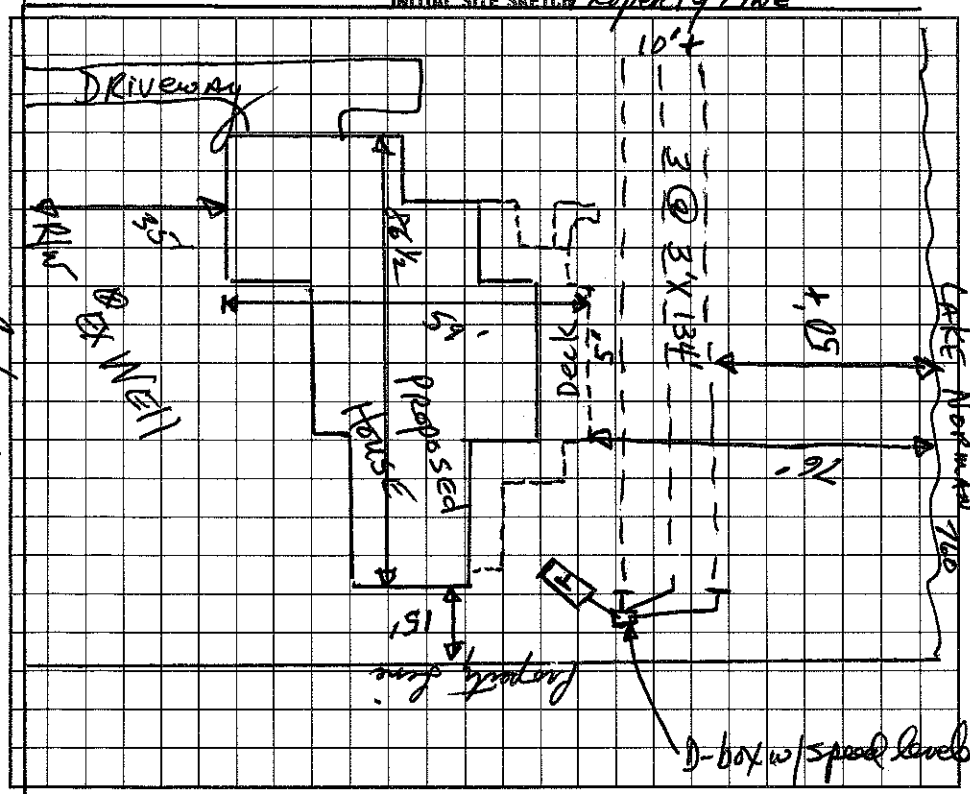

AS BUILT SKETCH

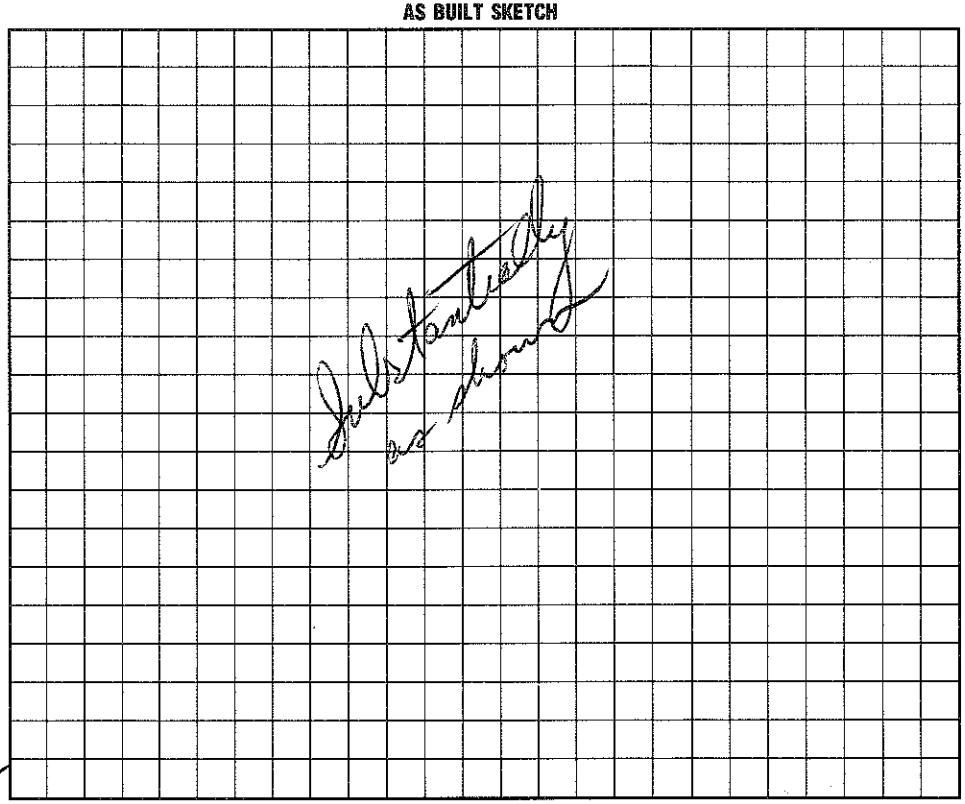

I understand that this permit can be suspended or revoked if any false information is supplied toward securing the permit/any unauthorized changes are made to the site/any unauthorized changes are made in the installation of the system. Improvement Permit is valid for 60 months from date of issuance.

Signed: X Jimmy Rodgers

Improvement Permit by: Jason R. Hinson, RS date 4/4/94

Existing System Inspection by: date

Installed by: Delbert Stanley

Certificate of Completion by: D R Hinson, RS date 11/18/94

Operation Permit by: date

HEALTH DEPT. COPY: WHITE INSPECTION COPY (FINAL): GREEN OWNER COPY (FINAL): YELLOW INSPECTION COPY (INITIAL): PINK OWNER COPY (INITIAL): GOLD