3:00

IREDELL COUNTY HEALTH DEPARTMENT

STATESVILLE 704-878-5305 MOORESVILLE 704-664-5281

IMPROVEMENT PERMIT / AUTHORIZATION TO CONSTRUCT / OPERATION PERMIT / EXISTING SYSTEM INSPECTION

PERMIT# 083228 PIN# 4637038061 DATE 3/6/99

OWNER OR CONTRACTOR Stanley Vaughn PHONE: Business Roger Cathey 361-5886 Home (704) 664-2066

ADDRESS 4332 Canebrook Rd Charlotte NC 28210

LOCATION 134 Culpeze Rd – Brawley School Rd TR Blume Rd to end TL Culpeze

SUBDIVISION C & T BLOCK / SECTION 4 LOT 141 LOT AREA .82 Acre SITE CLASS. PS DESIGN FLOW 480 gpd L.T.A.R. .3

Septic Tank: 1000 Gallons; STB 192 Date 8/18/00

Pump Tank: 1000 Gallons; PT 17 Date 6/21/00

Pump Make: Meyers Model SRM4ML Serial No.

Nitrification Field: No Fields 1 Square Feet 900' Linear Feet 300'

No Lines 6 at 50' Trench Width 36" Max Trench Bottom Depth 36"

[X] New System [ ] Repair System Type: I, II, III, IV, V, VI

System Description: Pump LP Panel Block

Repair System Description: Partial – Panel Block

Maintenance Agreement Required: [X] Yes [X] No

Gravel Depth N/A

[X] House/Mod. Home No. Bedrooms 4

[ ] Mobile Home No. Bathrooms 3

[ ] Business No. Employees

[ ] Other


[ ] Slab [X] Crawl Space [ ] Basement w/plumbing [ ] Basement wo/plumbing

Water Supply: [X] Individual [ ] Public [ ] Community


Comments:/Conditions: Keep Septic System at less 10' from PL, 5' from house & 50' from lake & at least 50' from any well.

Comments:/Conditions: Lot deeded prior to 1982. Poly lock Filter installed & riser installed Checked tanks & lines 11/16/2000.

INITIAL SITE SKETCH Scale 1:40

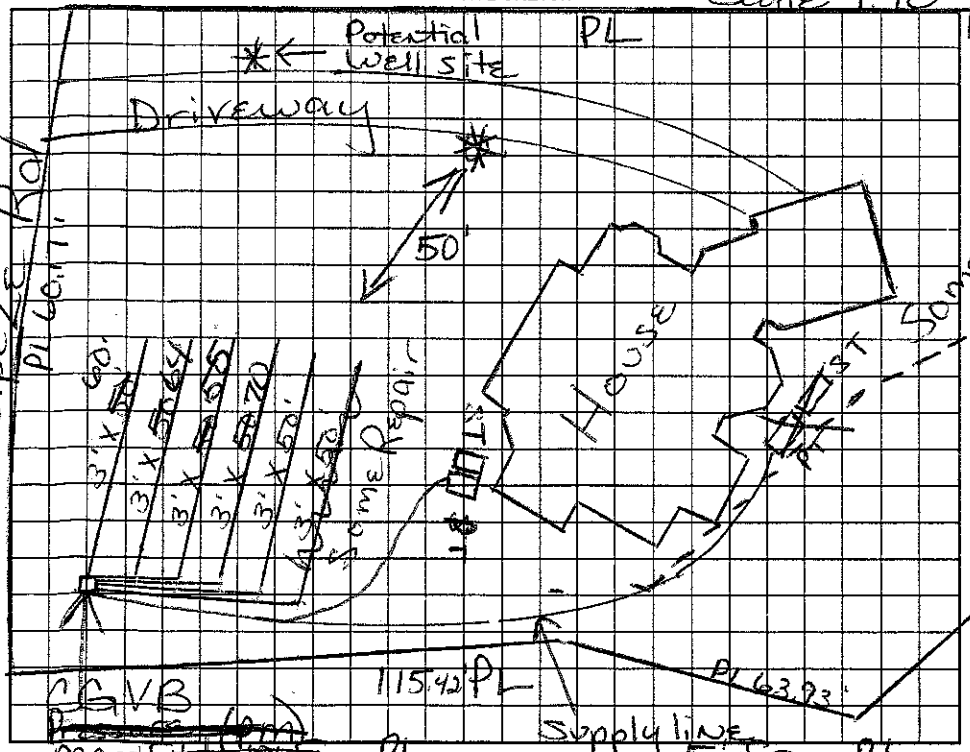

AS BUILT SKETCH

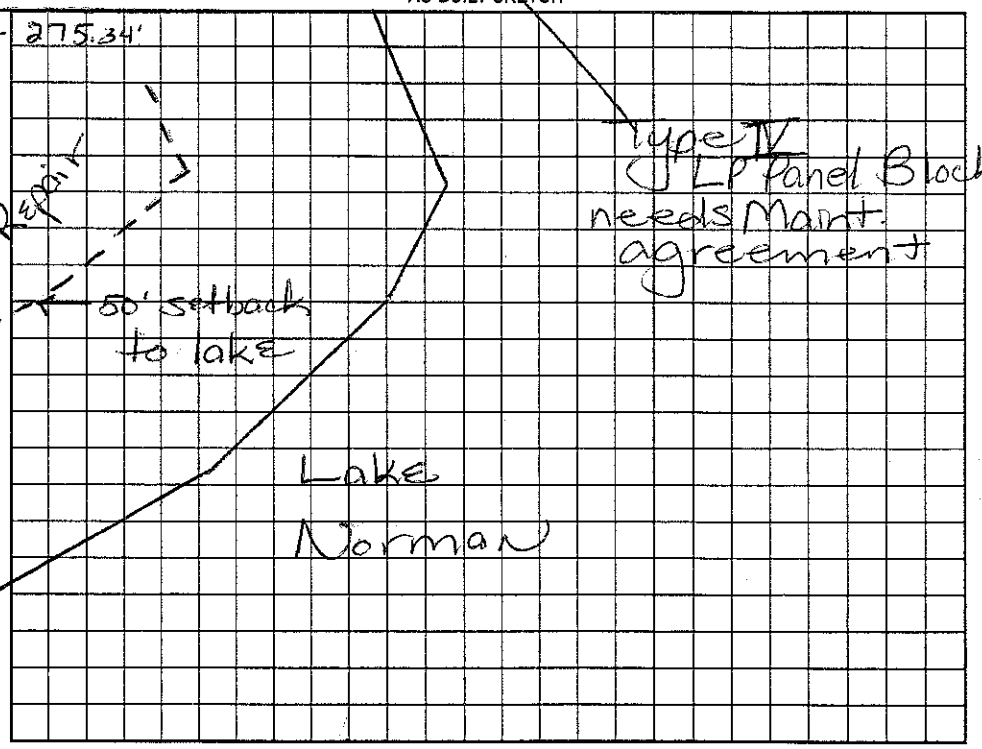

Permit can be suspended or revoked if any false information is supplied toward securing the permit/any unauthorized changes are made to the site/any unauthorized changes are made in the installation of the system. Improvement Permit with plat valid without expiration. Improvement Permit with site plan valid for sixty months. Authorization to Construct is valid for a period equal to that of Improvement Permit – not to exceed sixty months.

Signed: Roger Cathey date 3/8/00 Installed by: Richard Abernathy

Improvement Permit by: Maina M. Dotson RS date 3/7/99 Operation Permit by: Maina M. Dotson RS date 12/29/2000

Authorization to Construct by: Maina M. Dotson RS date 3/7/99 Existing System Inspection by: date

HEALTH DEPT. COPY: WHITE OWNER COPY (FINAL): YELLOW OWNER COPY (INITIAL): PINK