IREDELL COUNTY HEALTH DEPARTMENT

STATESVILLE 704-878-5305 MOORESVILLE 704-664-5281 3:00

IMPROVEMENT PERMIT / AUTHORIZATION TO CONSTRUCT / OPERATION PERMIT / EXISTING SYSTEM INSPECTION

PERMIT# 083228 PIN# 4637038061

OWNER OR CONTRACTOR Stanley Vaughn DATE 3/6/99

Roger Cathey

ADDRESS 4332 Canoebrook Rd Charlotte NC 28210 PHONE: Business 361-5886 Home (704) 664-2066

LOCATION 134 Culpeze Rd – Brawley School Rd TR Blume Rd to end TL Culpeze

SUBDIVISION CL & T BLOCK / SECTION 9 LOT 141 LOT AREA .82 Acre SITE CLASS. PS DESIGN FLOW 480gpd L.T.A.R. .3

Septic Tank: 1000 Gallons; STB 102 Date 8/18/00
Pump Tank: 1000 Gallons; PT 17 Date 6/21/00
Pump Make: Meyers Model SRM4MI Serial No.
Nitrification Field: No Fields 1 Square Feet 900' Linear Feet 300'
No Lines 6 at 50' Trench Width 36" Max Trench Bottom Depth 36" Gravel Depth N/A

☒ New System ☐ Repair System Type: I, II, [illegible] VI Type IV
System Description: Pump LP Panel Block
Repair System Description: Partial – Panel Block
Maintenance Agreement Required: ☒ Yes ☒ No
☐ Slab ☒ Crawl Space ☐ Basement w/plumbing ☐ Basement wo/plumbing


☒ House/Mod. Home ☐ Mobile Home ☐ Business ☐ Other
No. Bedrooms 4 No. Bathrooms 3 No. Employees

Water Supply: ☒ Individual ☐ Public ☐ Community


Comments:/Conditions: Keep Septic System at less 10' from PL, 5' from house & 50' from lake & at least 50' from any well.

Comments:/Conditions: Lot deeded prior to 1982. Polylock Filter installed & riser installed. Checked tanks & lines 11/16/2000.

INITIAL SITE SKETCH Scale 1:40

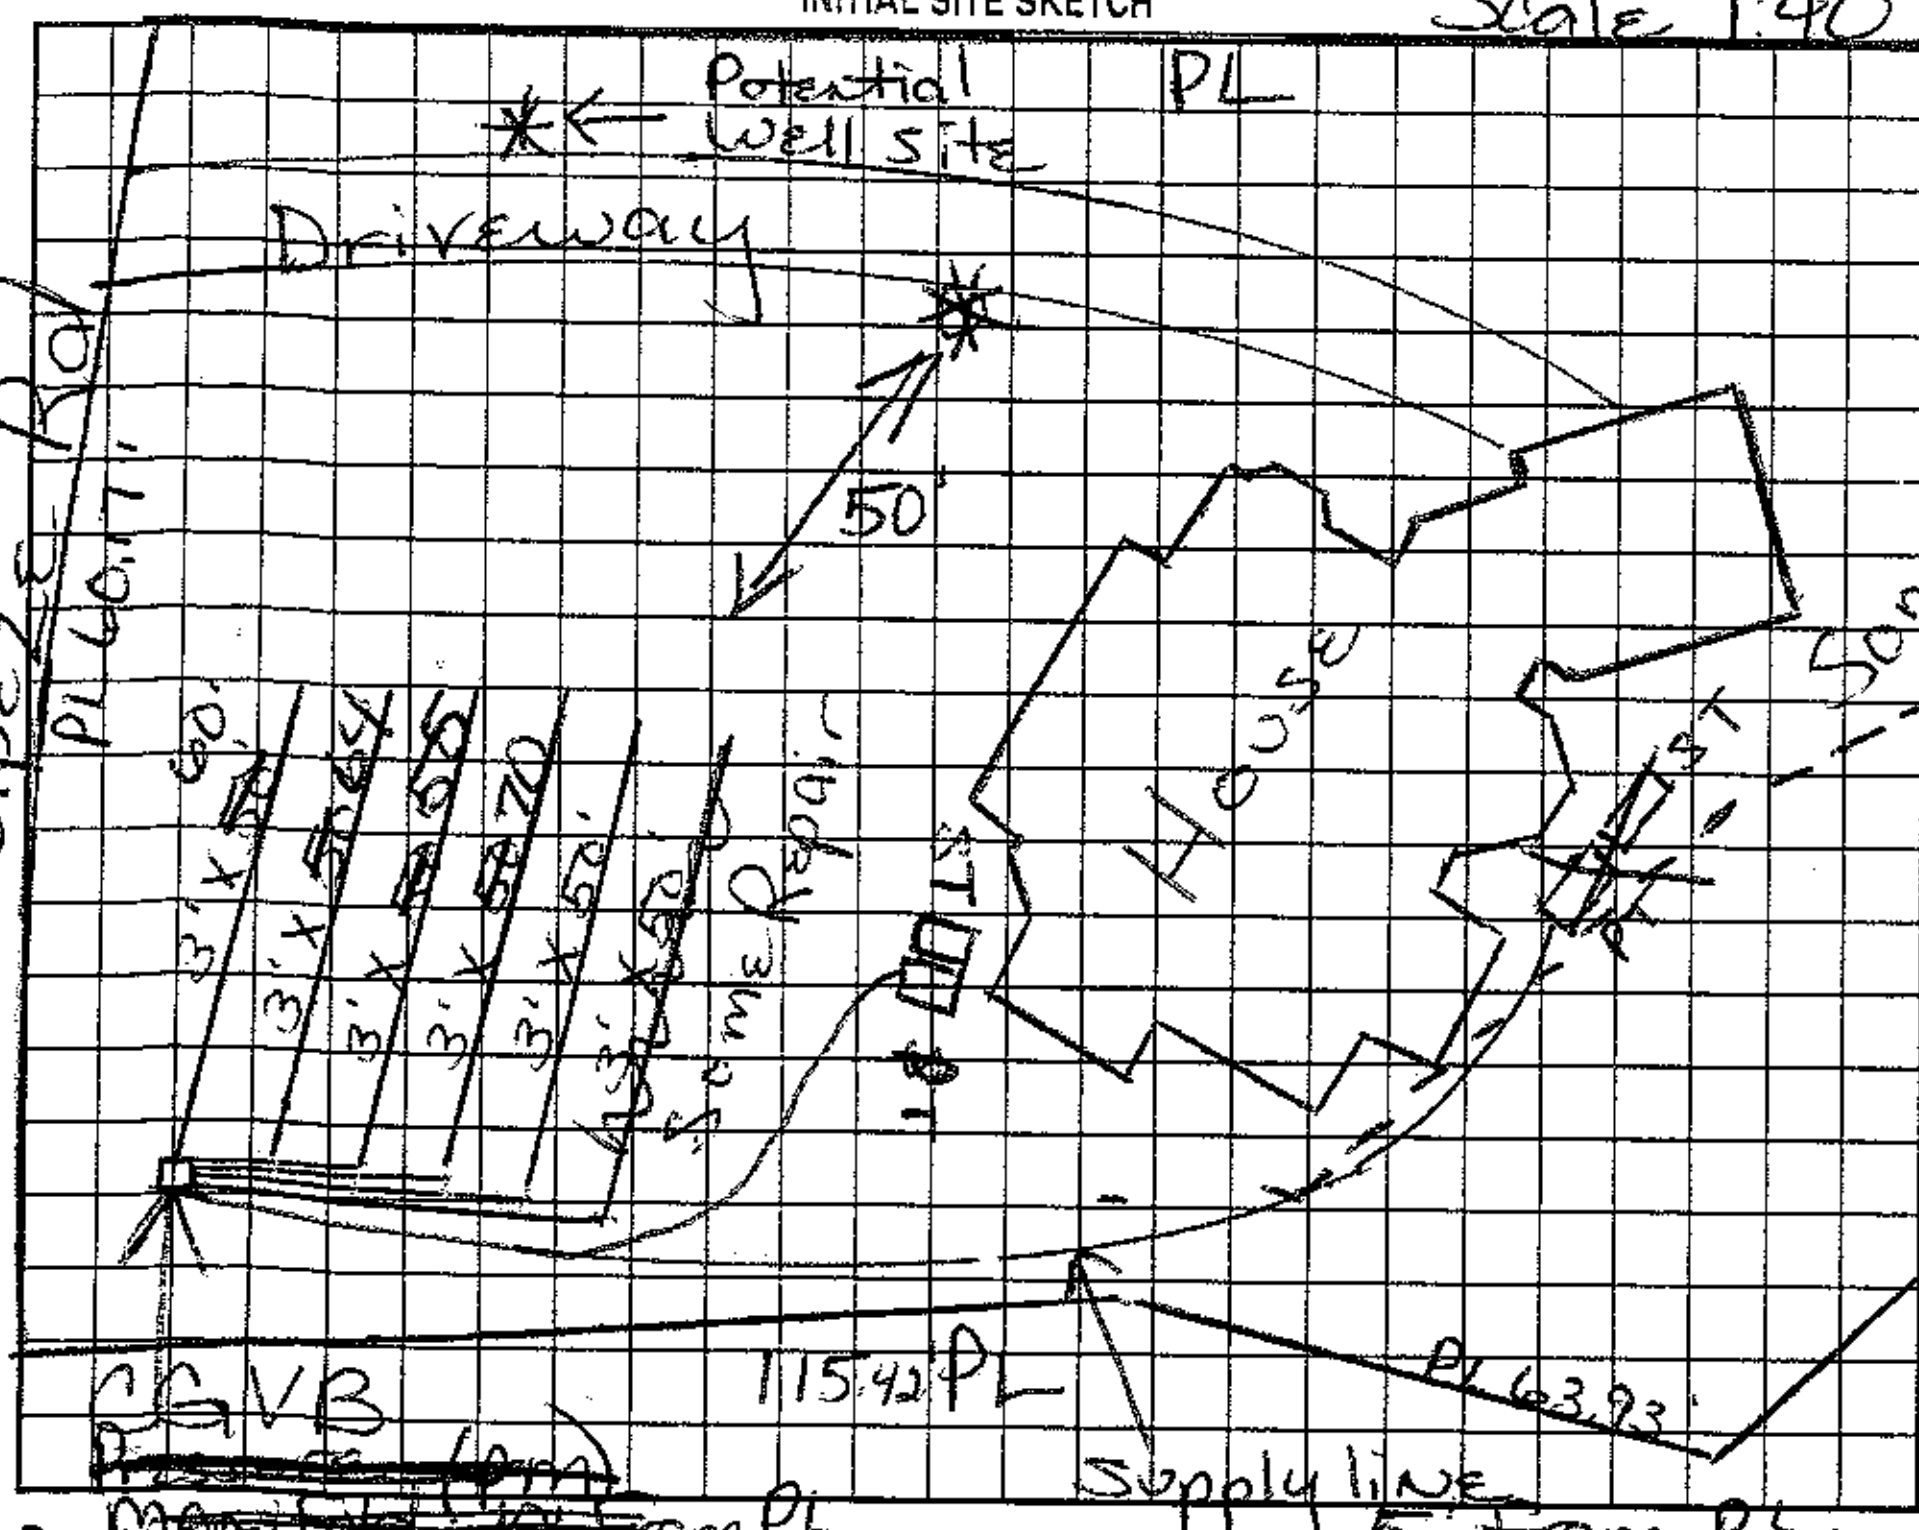

AS BUILT SKETCH

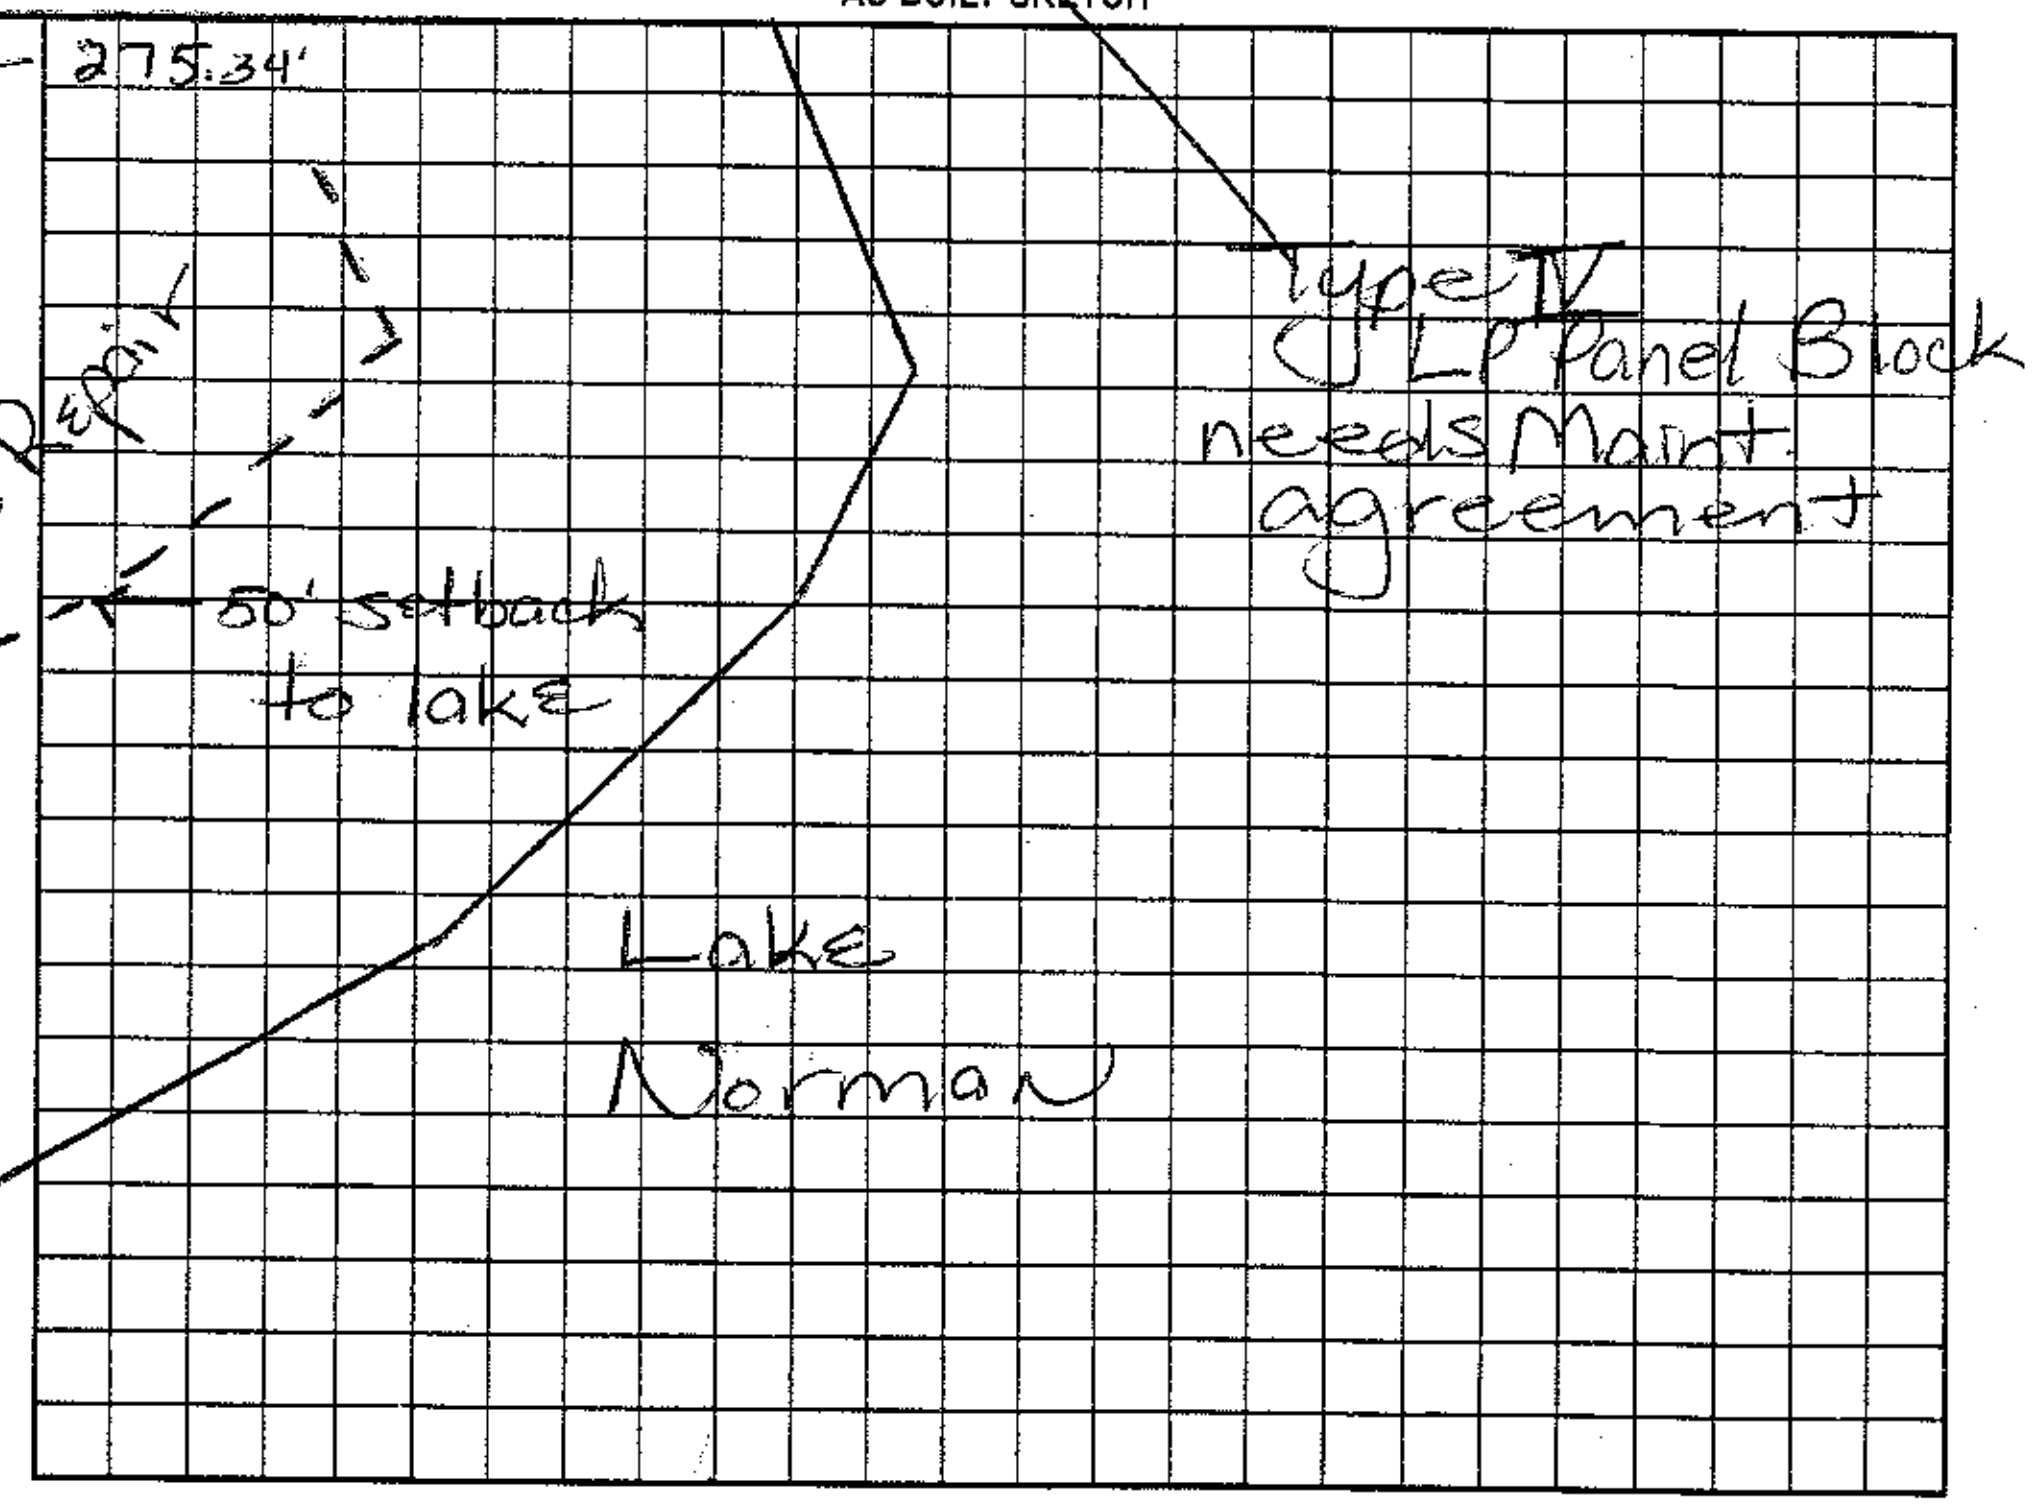

Permit can be suspended or revoked if any false information is supplied toward securing the permit/any unauthorized changes are made to the site/any unauthorized changes are made in the installation of the system. Improvement Permit with plat valid without expiration. Improvement Permit with site plan valid for sixty months. Authorization to Construct is valid for a period equal to that of Improvement Permit – not to exceed sixty months.

Signed: [signature] date 3/8/00
Improvement Permit by: Maria H. Dobson RS date 3/7/99
Authorization to Construct by: Maria H. Dobson RS date 3/7/99

Installed by: Richard Abernathy
Operation Permit by: Maria H. Dobson RS date 12/29/2000
Existing System Inspection by: date

HEALTH DEPT. COPY: WHITE OWNER COPY (FINAL): YELLOW OWNER COPY (INITIAL): PINK

