IREDELL COUNTY HEALTH DEPARTMENT

STATESVILLE 704-878-5305 MOORESVILLE 704-664-5281

IMPROVEMENT PERMIT / AUTHORIZATION TO CONSTRUCT / OPERATION PERMIT / EXISTING SYSTEM INSPECTION

PERMIT# 083862 PIN# 4637040889 / 4637040867 DATE 10-20-99

OWNER OR CONTRACTOR Celia Hunter PHONE: Business Estelle Jack 664-9309 Home 572-4733 Cell 572-4733

ADDRESS 626 Heatherly Mooresville, NC 28115

LOCATION Hwy 150 W. TL McCrary TR Riverwood .4 miles on left #305

SUBDIVISION — BLOCK / SECTION — LOT 78 LOT AREA .95 Acre SITE CLASS. PS DESIGN FLOW 480gpd L.T.A.R. .3

Septic Tank: 1000 Gallons; STB 1012 Date 4-18-00
Pump Tank: — Gallons; PT — Date —
Pump Make: — Model — Serial No. —
Nitrification Field: No Fields 1 Square Feet 810' Linear Feet 270'
No Lines 6 at 45' Trench Width 36" Max Trench Bottom Depth 36" Gravel Depth N/A

☒ New System ☐ Repair System Type: I, II, III, IV, V, VI
System Description: Gravity – Panel Blk *
Repair System Description: Pump – Panel Blk
Maintenance Agreement Required: ☐ Yes ☒ No


☒ House/Mod. Home No. Bedrooms 4
☐ Mobile Home No. Bathrooms 3
☐ Business No. Employees —
☐ Other —
☐ Slab ☐ Crawl Space ☒ Basement w/plumbing ☐ Basement wo/plumbing

Water Supply: ☒ Individual ☐ Public ☐ Community

Comments:/Conditions: * 50% Reduction in Drainfield Area
Keep Septic System at least 5' from House, 10' from PL, 50' from any well & 50' from lake
Keep New well 25' from House, 50' from any Septic System & 50' from lake

Comments:/Conditions: Filter & riser
Checked upper 4 lines & tank. 7/12/2000

INITIAL SITE SKETCH

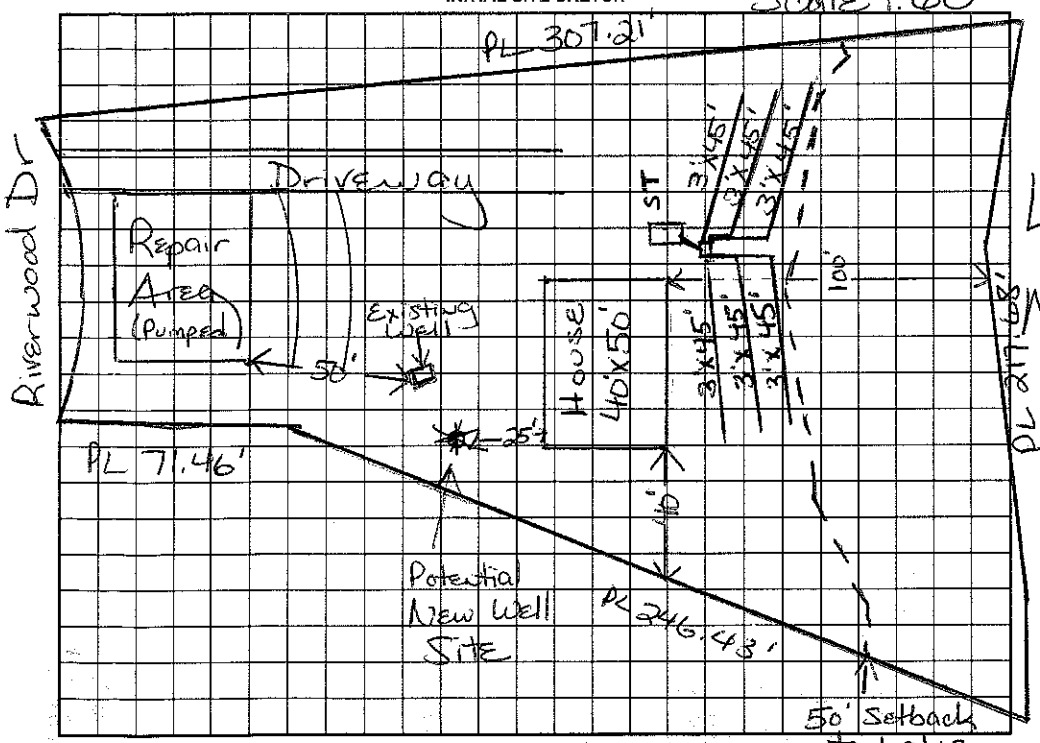

AS BUILT SKETCH

Permit can be suspended or revoked if any false information is supplied toward securing the permit/any unauthorized changes are made to the site/any unauthorized changes are made in the installation of the system. Improvement Permit with plat valid without expiration. Improvement Permit with site plan valid for sixty months. Authorization to Construct is valid for a period equal to that of Improvement Permit – not to exceed sixty months.

Signed: Celia Hunter date 10/21/99 Installed by: Richard Abernathy

Improvement Permit by: Maina H. Dotson date 10/20/99 Operation Permit by: Maina H. Dotson RS date 7/14/2000

Authorization to Construct by: Maina H. Dotson date 10/20/99 Existing System Inspection by: — date —

HEALTH DEPT. COPY: WHITE OWNER COPY (FINAL): YELLOW OWNER COPY (INITIAL): PINK