4637042814

IREDELL COUNTY HEALTH DEPARTMENT

AUTHORIZATION TO CONSTRUCT

BRADY FREEMAN 664-3718

STATESVILLE 704-878-5305 MOORESVILLE 704-664-5281

IMPROVEMENT PERMIT / ~~CERTIFICATE OF COMPLETION~~ / OPERATION PERMIT / EXISTING SYSTEM INSPECTION

PROPERTY DESCRIPTION NO. 25306 DATE 10/29/96 TAX MAP NO. 2P-3-A-77 Watershed: ☑ Yes ☐ No

OWNER OR CONTRACTOR SHARON JUNE PHONE: Business 483-9844 (SPIVEY) Home

ADDRESS 7000 HYDE ST SHELLBALLS FORD

LOCATION 150 W-TL MCCRARY-TR RIVERWOOD ON LEFT - # 301

SUBDIVISION CLT BLOCK / SECTION 10 LOT 77 LOT AREA - SITE CLASS. PS DESIGN FLOW 240 L.T.A.R. EXISTING

Septic Tank: EXISTING Gallons; STB Date

Pump Tank: Gallons; PT Date

Pump Make: Model Serial No.

Nitrification Field: No Fields Square Feet Linear Feet

No Lines Trench Width Max Trench Bottom Depth Gravel Depth

☐ New System ☐ Repair System Type: I, II, III, IV, V, VI

System Description: EXISTING

Repair System Description:

Maintenance Agreement Required: ☐ Yes ☐ No

☐ Slab ☑ Crawl Space ☐ Basement w/plumbing ☐ Basement wo/plumbing

☐ House/Mod. Home No. Bedrooms 2

☑ Mobile Home No. Bathrooms 2

☐ Business No. Employees


☐ Other

Water Supply: ☑ Individual ☐ Community ☐ Public

Comments: BEDROOM FROM TRAILOR IS TO BE REMOVED TO MAKE BR # THE SAME BEFORE FINAL INSPECTION IS COMPLETE. NEW WELL WILL BE PLACED 40' FROM PROPERTY LINE.

Comments:

INITIAL SITE SKETCH

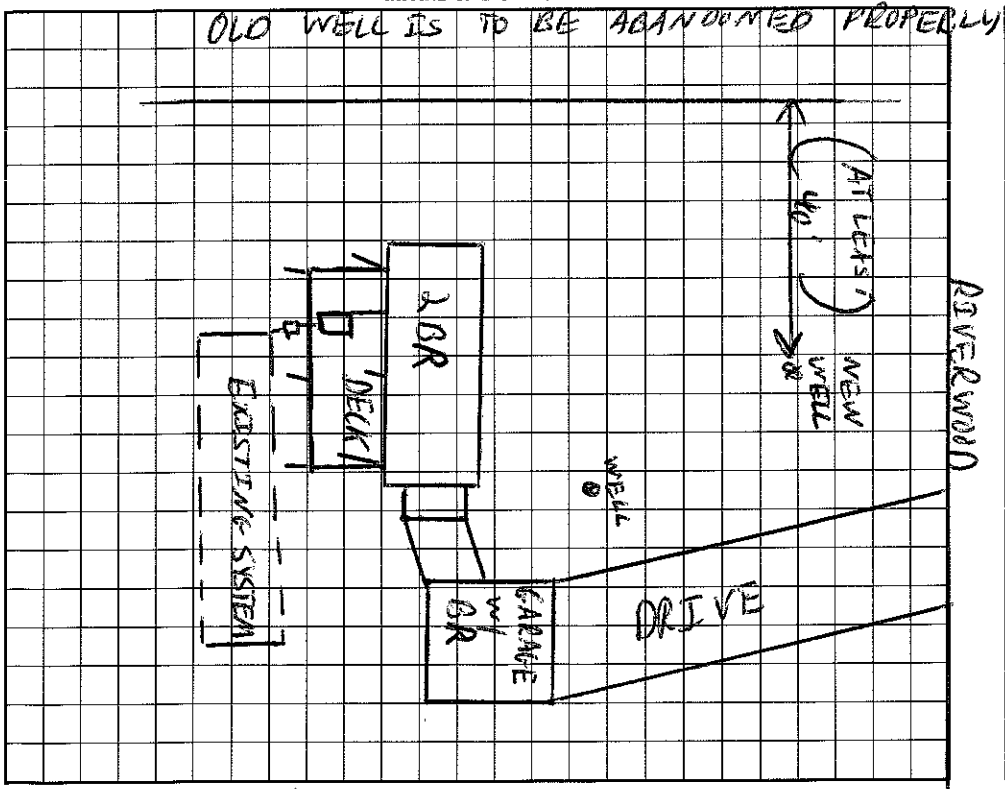

AS BUILT SKETCH

I understand that this permit can be suspended or revoked if any false information is supplied toward securing the permit/any unauthorized changes are made to the site/any unauthorized changes are made in the installation of the system.

Signed: Willis Spivey

Improvement Permit by: C. Ruth Ferguson EHS date 10/29/96

Existing System Inspection by: C. Ruth Ferguson EHS date 10/29/96

Installed by:

Certificate of Completion by: date

Operation Permit by: C. Ruth Ferguson EHS date 10/29/96

HEALTH DEPT. COPY: WHITE INSPECTION COPY (FINAL): GREEN OWNER COPY (FINAL): YELLOW INSPECTION COPY (INITIAL): PINK OWNER COPY (INITIAL): GOLD