Existing System/Pool over

# IREDELL COUNTY HEALTH DEPARTMENT

STATESVILLE 704-878-5305 MOORESVILLE 704-664-5281

## IMPROVEMENT PERMIT / AUTHORIZATION TO CONSTRUCT / OPERATION PERMIT / EXISTING SYSTEM INSPECTION

PERMIT # 156364 PIN # 4637055481.000 DATE 5/11/09

OWNER or APPLICANT John Spates PHONE: Business Home: 704 450-4929

OWNER or APPLICANT ADDRESS 334 Riverwood Rd.

LOCATION / DIRECTIONS Hwy 150 W TL McCrary Rd. TR Riverwood Rd. Lot on Right

SUBDIVISION McCrary Woods BLOCK / SECTION LOT # 5 LOT AREA .748 DESIGN FLOW 480 L.T.A.R. .25

Septic Tank @ 1000 Gallons: STB Date

Pump Tank Gallons: P T Date

Pump Make Model @80' Serial #

Nitrification Field No Fields 1 No Lines 6 Linear Feet Ex. 480'

Trench Width 36 Max. Trench Bottom Depth 36 Gravel Depth N/A

☐ New System ☐ Repair ☐ Expansion System Type I II III IV V VI

System Description:

Repair System Description: Existing System

Maintenance Agreement Required ☐ YES ☑ NO

☑ GRAVITY ☐ PRESSURE

☑ Residence No. Bedrooms 4

☐ Business No. Persons

☐ Other No. Employees

☐ Slab ☑ Crawl Space


☐ Basement w/plumbing ☐ Basement w/o plumbing

Water Supply: ☑ Private Ex's ☐ Public ☐ Community

Comments / Conditions


Comments / Conditions Exis Pool cut is 15' from Existing Septic system at closest point. Existing drainlines are probably EZ Flow product.

INITIAL SITE SKETCH

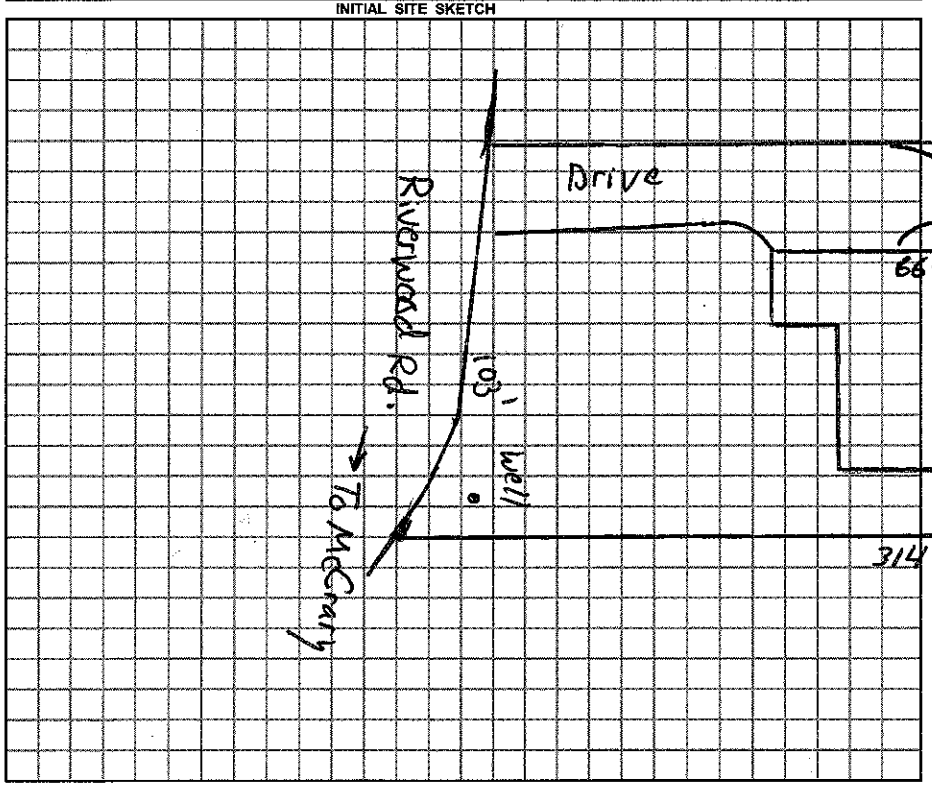


AS BUILT SKETCH

1" ≈ 50'

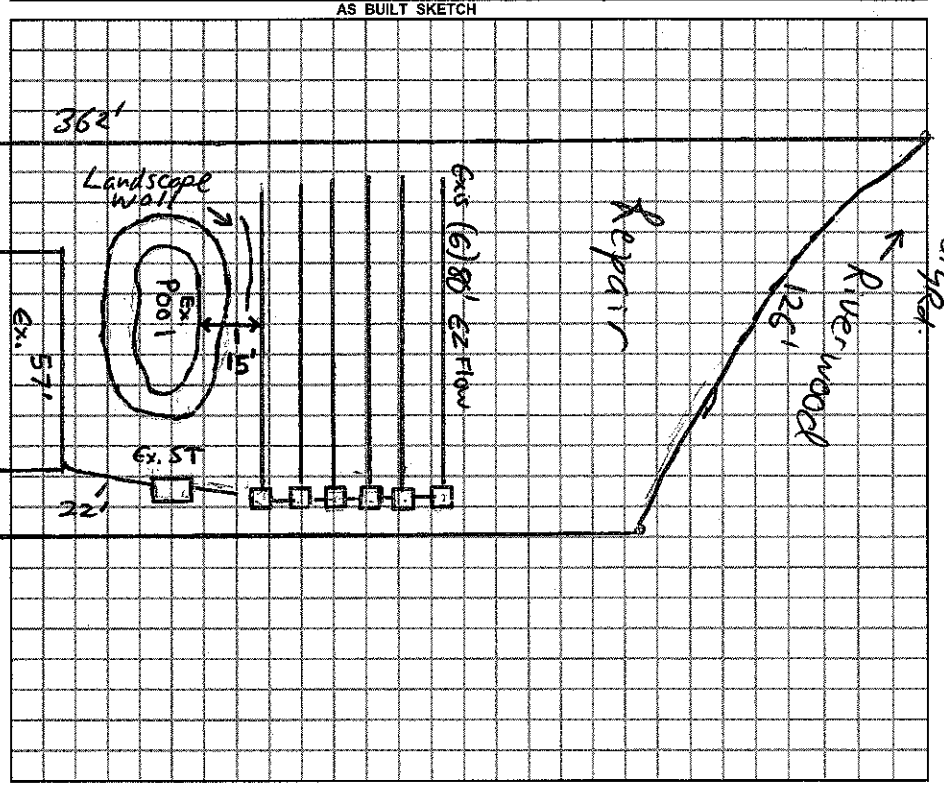


*Permit can be suspended or revoked if any false information is supplied toward securing the permit / any unauthorized changes are made to the site / any unauthorized changes are made in the installation of the system.*

☐ *IMPROVEMENT PERMIT w / plan valid without expiration.* ☐ *IMPROVEMENT PERMIT w / site plan valid for 60 mos.* ☐ *AUTHORIZATION TO CONSTRUCT valid for period equal to IMPROVEMENT PERMIT-not to exceed 60 mo.*

Owner / Applicant Signature: John W. Spates Date 5/12/09

Improvement Permit by: Date

Authorization to Construct by: Date

***YOU SHOULD CONTACT A LOCATOR SERVICE PRIOR TO ANY EXCAVATION.***

Installed by:

Operation Permit by: Date:

Existing System Inspected by: Anthony Cokes Jr. R.S. Date: 5/11/09

WHITE COPY Environmental Health YELLOW COPY (Final) Owner / Applicant PINK COPY (Initial) Owner / Applicant