IREDELL COUNTY HEALTH DEPARTMENT

STATESVILLE 704-878-5305 MOORESVILLE 704-664-5281

IMPROVEMENT PERMIT / AUTHORIZATION TO CONSTRUCT / OPERATION PERMIT / EXISTING SYSTEM INSPECTION

130

PERMIT# 19527 PIN# 4637166015.005 DATE 7/15/04

OWNER OR CONTRACTOR McCrary Partners PHONE: Business 799-9770 Home

ADDRESS ~~168 Brandon~~ PO Box 3608 Mooresville, NC 28117

LOCATION 150 West - TL McCrary - TR Riverwood - on RT

SUBDIVISION McCrary Woods BLOCK / SECTION LOT 5 LOT AREA .76Ac SITE CLASS. PS DESIGN FLOW 480GPD L.T.A.R. .256PD/FT²

Septic Tank: 1000 Gallons: STB 160 Date 4/13/05

Pump Tank: Gallons: PT Date

Pump Make: Model Serial No.

Nitrification Field: No Fields 1 Square Feet 1440 Linear Feet 480

No Lines 6@80' Trench Width 36" Max Trench Bottom Depth 36" Gravel Depth N/A

☑ New System ☐ Repair System Type: I, II, (III), IV, V, VI

System Description: GRAVITY 25% REDUCTION

Repair System Description: LP PANEL

Maintenance Agreement Required: ☐ Yes ☑ No

☑ House/Mod. Home No. Bedrooms 4

☐ Mobile Home No. Bathrooms 4

☐ Business No. Employees

☐ Other


☐ Slab ☑ Crawl Space ☐ Basement w/plumbing ☐ Basement wo/plumbing

Water Supply: ☑ Individual ☐ Public ☐ Community


Comments:/Conditions:

Comments:/Conditions:

INITIAL SITE SKETCH 1"=50'

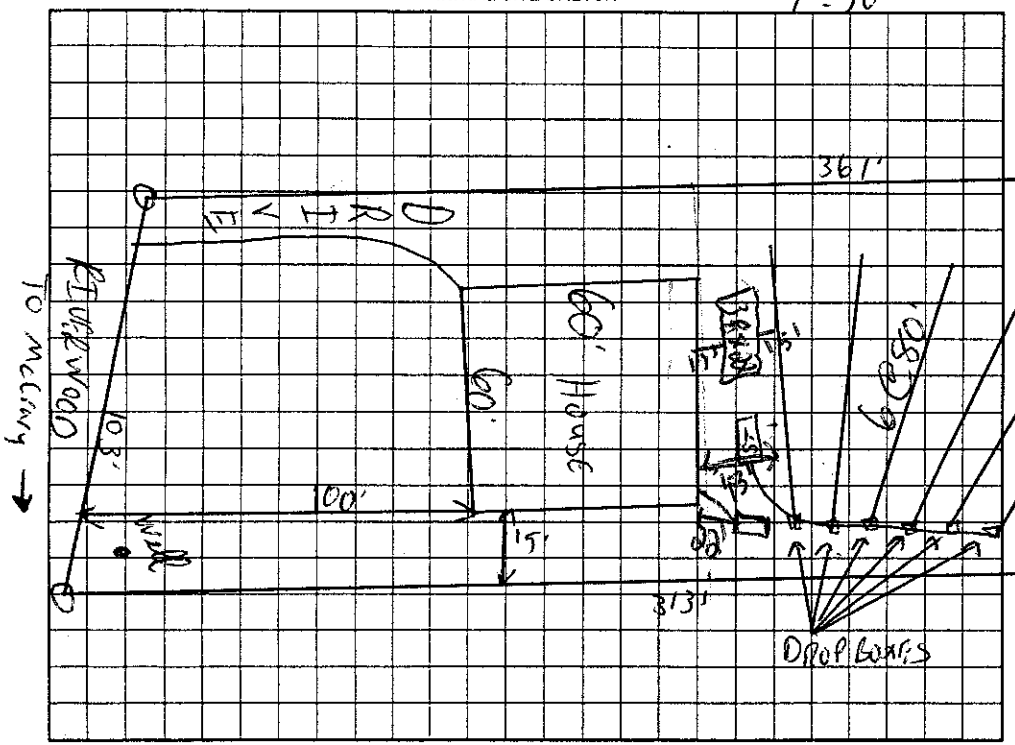

AS BUILT SKETCH

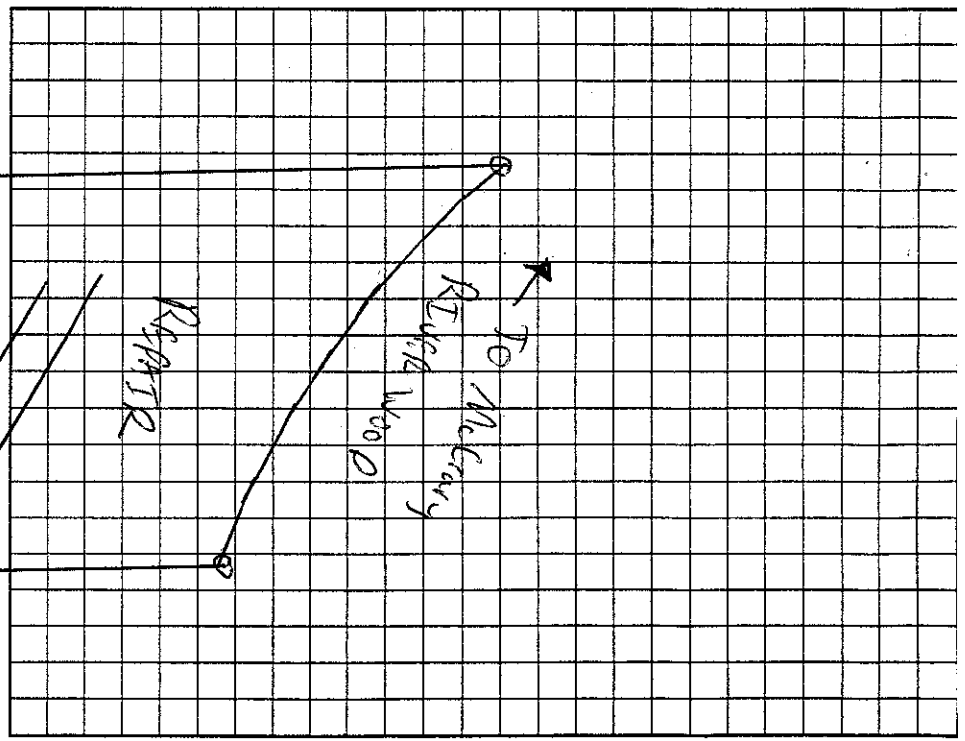

Permit can be suspended or revoked if any false information is supplied toward securing the permit/any unauthorized changes are made to the site/any unauthorized changes are made in the installation of the system. Improvement Permit with plat valid without expiration. Improvement Permit with site plan valid for sixty months. Authorization to Construct is valid for a period equal to that of Improvement Permit – not to exceed sixty months.

Signed: date 8-3-04 Installed by:

Improvement Permit by: C. [illegible] RS date 7/15/04 Operation Permit by: Wesley Sparks RI date 8/22/05

Authorization to Construct by: C. [illegible] RS date 7/22/05 Existing System Inspection by: date

HEALTH DEPT. COPY: WHITE OWNER COPY (FINAL): YELLOW OWNER COPY (INITIAL): PINK