120

IREDELL COUNTY HEALTH DEPARTMENT

STATESVILLE 704-878-5305 MOORESVILLE 704-664-5281

IMPROVEMENT PERMIT / AUTHORIZATION TO CONSTRUCT / OPERATION PERMIT / EXISTING SYSTEM INSPECTION

PERMIT# 119529 PIN# ~~4637166015.000~~ 4637-05-7660 DATE 7/15/04

OWNER OR CONTRACTOR McCRARY PARTNERS / Mid Atlantic Custom Homes PHONE: Business 799-9770 Home

ADDRESS PO BOX 3608 MOORESVILLE, NC 28117

LOCATION 150 WEST - TL McCRARY - JR RIDGEWOOD - ON RT

SUBDIVISION McCRARY WOODS BLOCK / SECTION 1 LOT 7 LOT AREA .76AC SITE CLASS. PS DESIGN FLOW 450GPD T.A.R. .36Ro/Kf=

Septic Tank: 1000 Gallons; STB 312 Date 3/5/04

Pump Tank: Gallons; PT Date

Pump Make: Model Serial No.

Nitrification Field: No Fields 1 Square Feet 1200 Linear Feet 400

No Lines 4@100' Trench Width 36" Max Trench Bottom Depth 36" Gravel Depth N/A

☑ New System ☐ Repair System Type: I II III IV V VI

System Description: GRAVITY 25% REDUCTION

Repair System Description: SAME

Maintenance Agreement Required: ☐ Yes ☑ No

☑ House/Mod. Home No. Bedrooms 4

☐ Mobile Home No. Bathrooms 4

☐ Business No. Employees

☐ Other


☐ Slab ☑ Crawl Space ☐ Basement w/plumbing ☐ Basement wo/plumbing

Water Supply: ☑ Individual ☐ Public ☐ Community


Comments:/Conditions:

Comments:/Conditions:

INITIAL SITE SKETCH 1"=50'

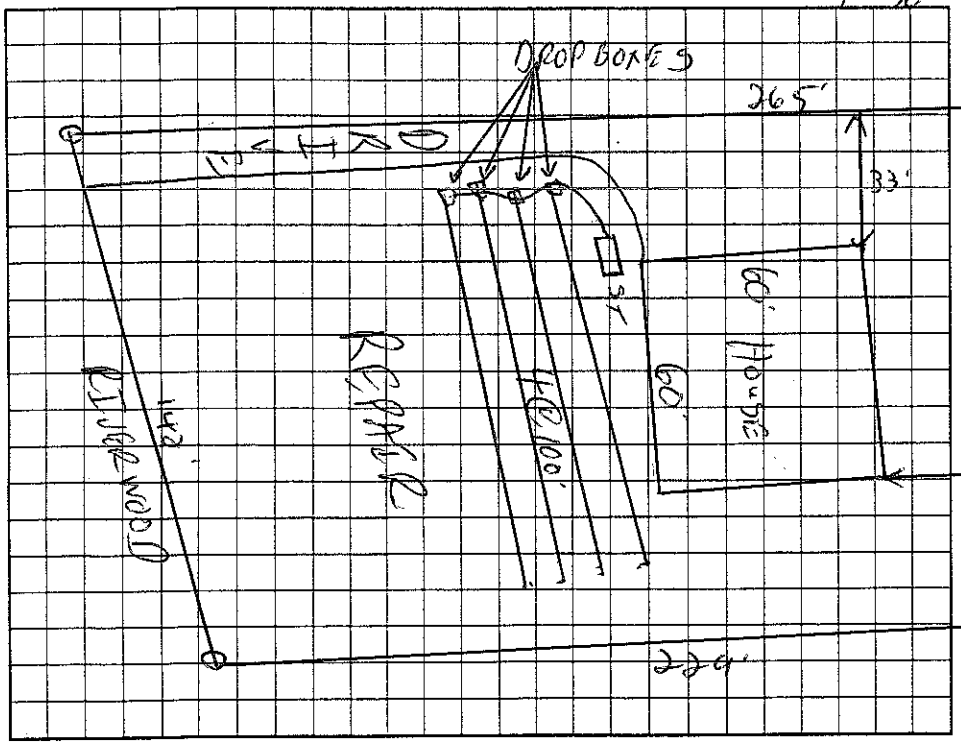

AS BUILT SKETCH

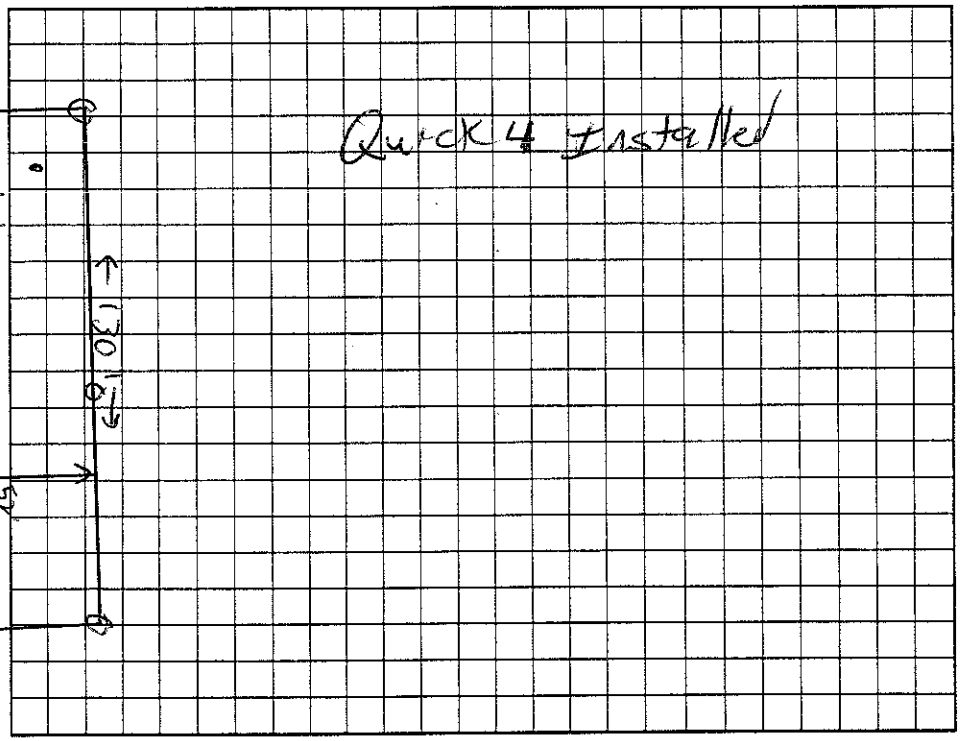

Permit can be suspended or revoked if any false information is supplied toward securing the permit/any unauthorized changes are made to the site/any unauthorized changes are made in the installation of the system. Improvement Permit with plat valid without expiration. Improvement Permit with site plan valid for sixty months. Authorization to Construct is valid for a period equal to that of Improvement Permit – not to exceed sixty months.

Signed: date 8-3-04 Installed by: Howard's Backhoe

Improvement Permit by: RS date 7/15/04 Operation Permit by: RS date 6/19/06

Authorization to Construct by: RS date 2/6/06 Existing System Inspection by: date

HEALTH DEPT. COPY: WHITE OWNER COPY (FINAL): YELLOW OWNER COPY (INITIAL): PINK