IREDELL COUNTY HEALTH DEPARTMENT

STATESVILLE 704-878-5305 MOORESVILLE 704-664-5281

IMPROVEMENT PERMIT / AUTHORIZATION TO CONSTRUCT / OPERATION PERMIT / EXISTING SYSTEM INSPECTION

PERMIT# 138709zo PIN# 4637057909 DATE 10/27/06

OWNER OR APPLICANT Todd Hoorick PHONE: Business _____ Home _____

ADDRESS 369 Riverwood Rd Mooresville 28117

LOCATION Hwy 150 W, Lt McCrary, Rt Riverwood, ½ Mile On Lt

SUBDIVISION CLOT BLOCK / SECTION 10 LOT 88 LOT AREA .08 Ac SITE CLASS. _____ DESIGN FLOW +120gpd T.A.R. .3 gpd/ft2

Septic Tank: EXISTING Gallons: ST8 _____ Date _____
Pump Tank: _____ Gallons: PT _____ Date _____
Pump Make: _____ Model _____ Serial No. _____
Nitrification Field: No. Fields 1 Square Feet 300 Linear Feet 100
No Lines 2@50 Trench Width 36" Max Trench Bottom Depth 36"

☐ New System ☐ Repair ☒ Expansion System Type: I (II) III IV V VI
System Description: GRAVITY 25% REDUCTION
Repair System Description: PANEL
Maintenance Agreement Required: ☐ Yes ☒ No

☐ House/Mod. Home No. Bedrooms +1
☐ Mobile Home No. Persons _____
☐ Business No. Employees _____
☐ Other _____


Water Supply: ☒ Individual ☐ Public ☐ Community

Gravel Depth N/A ☒ Gravity ☐ Pressure ☐ Slab ☒ Crawl Space ☐ Basement w/plumbing ☐ Basement wo/plumbing


Comments/Conditions: EXISTING 2BR HOUSE, NOW ADDING 1 BR (ENCLOSING SIDE DECK) USING EXISTING 2BR SYSTEM IN CONJUNTION WITH NEW SYSTEM

Comments/Conditions: NEW SYSTEM; FOLLOW CONTOURS - KEEP LINES 9' ON CENTER

INITIAL SITE SKETCH

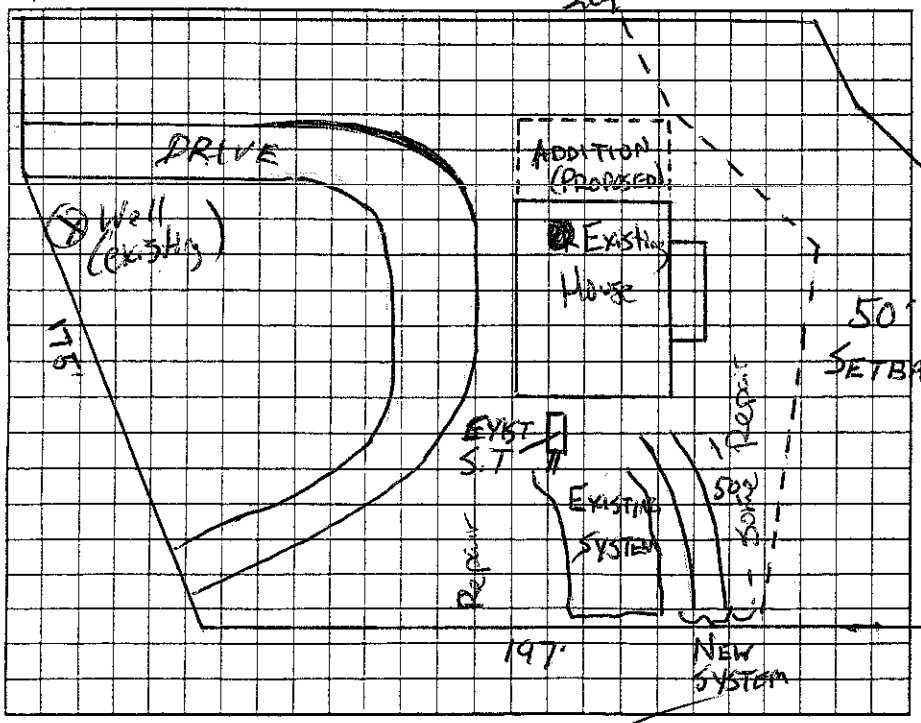

AS BUILT SKETCH

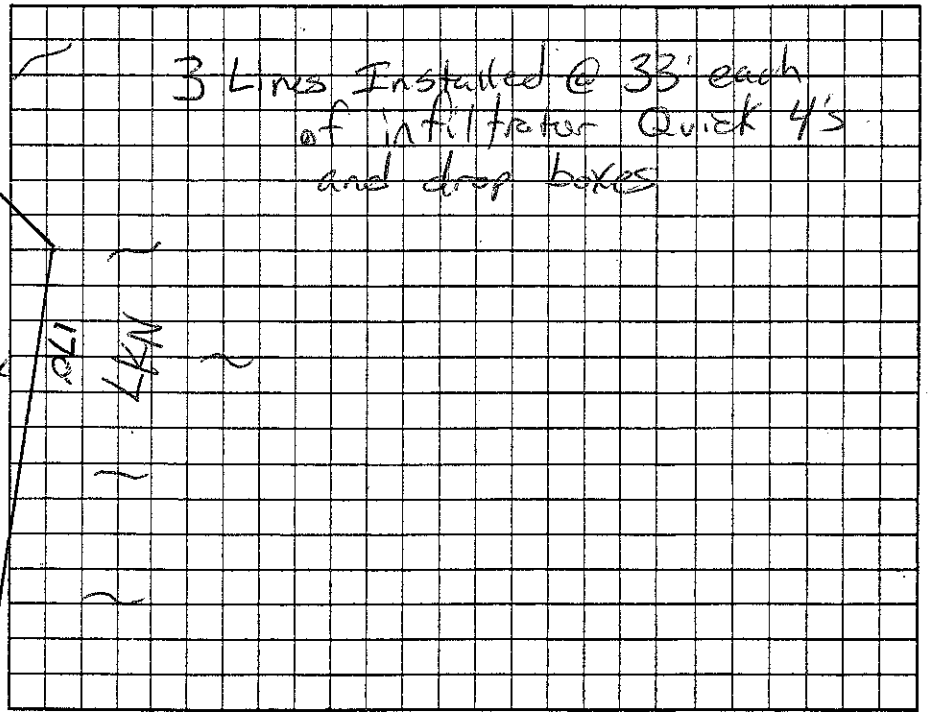

Permit can be suspended or revoked if any false information is supplied toward securing the permit/any unauthorized changes are made to the site/any unauthorized changes are made in the installation of the system. Improvement Permit with plat valid without expiration ☐ Improvement Permit with site plan valid for sixty months ☐ Authorization to Construct is valid for a period equal to that of Improvement Permit – not to exceed sixty months.

Signed: Todd Hoorick date 10/30/06 Installed by: Richard Abernathy

Improvement Permit by: _____ date _____ Operation Permit by: Joseph E Allen date 4-17-07

Authorization to Construct by: Joseph E Allen date 10/27/06 Existing System Inspection by: Joseph E Allen date 10/27/06

HEALTH DEPT. COPY: WHITE OWNER COPY (FINAL): YELLOW OWNER COPY (INITIAL): PINK