130

IREDELL COUNTY HEALTH DEPARTMENT

STATESVILLE 704-878-5305 MOORESVILLE 704-664-5281

IMPROVEMENT PERMIT / AUTHORIZATION TO CONSTRUCT / OPERATION PERMIT / EXISTING SYSTEM INSPECTION

PERMIT# 119541 PIN# ~~4637166015.014~~ 4637-05-8306 DATE 7/14/04

OWNER OR CONTRACTOR McCRARY PARTNERS PHONE: Business 799-9770 Home

ADDRESS PO Box 3608 MOORESVILLE NC 28117

LOCATION 150 West - TL McCRARY - JR RIVERWOOD - DV RT

SUBDIVISION McCRARY WOODS BLOCK / SECTION 1 LOT 14 LOT AREA .73Ac SITE CLASS. PS DESIGN FLOW 480GPD L.T.A.R. .25GPD/FT²

Septic Tank: 1000 Gallons; STB 160 Date 7/22/05
Pump Tank: Gallons; PT Date
Pump Make: Model Serial No.
Nitrification Field: No Fields 1 Square Feet 640 Linear Feet 320
No Lines 8@40' Trench Width ~~2'~~ 24" Max Trench Bottom Depth 36" Gravel Depth N/A

☑ New System ☐ Repair System Type: I, II, III, IV, V, VI
System Description: GRAVITY PANEL
Repair System Description: LP PANEL
Maintenance Agreement Required: ☐ Yes ☑ No


☑ House/Mod. Home No. Bedrooms 4
☐ Mobile Home No. Bathrooms 4
☐ Business No. Employees
☐ Other
☐ Slab ☑ Crawl Space ☐ Basement w/plumbing ☐ Basement wo/plumbing

Water Supply: ☑ Individual ☐ Public ☐ Community

Comments:/Conditions: 3/31/05 Driveway 12' wide and entering from Ⓓ front to Ⓛ corner of house.

Comments:/Conditions: ST W MARKER AND LABEL RISER INSTALLED WITH 72 TBJ PPBPS

INITIAL SITE SKETCH

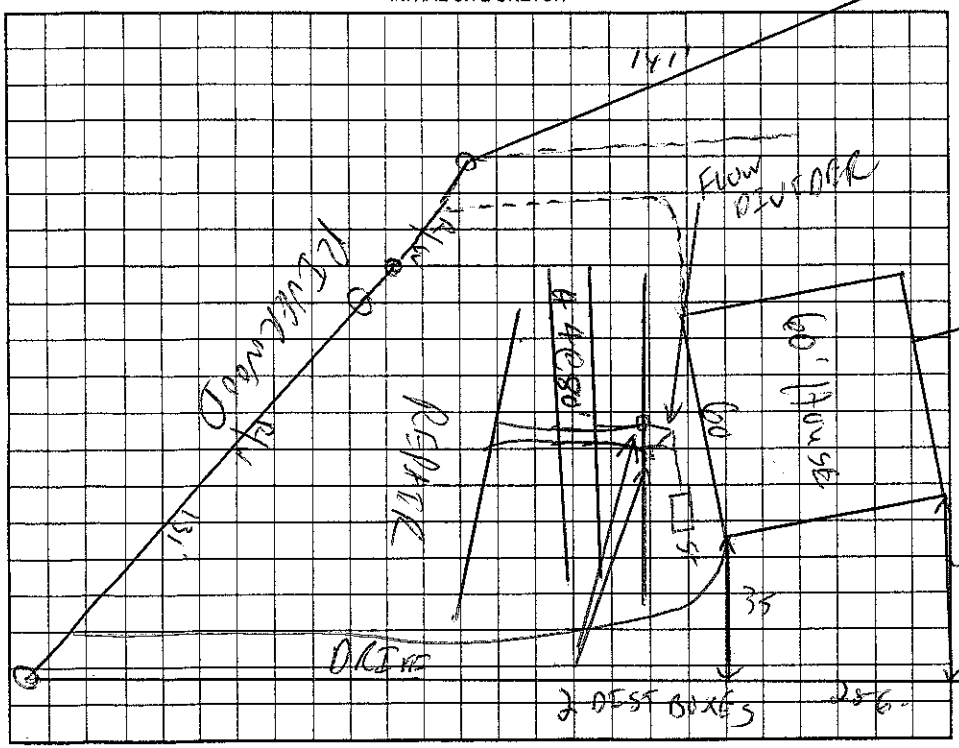

AS BUILT SKETCH

Permit can be suspended or revoked if any false information is supplied toward securing the permit/any unauthorized changes are made to the site/any unauthorized changes are made in the installation of the system. Improvement Permit with ~~plat~~ valid without expiration. ~~Improvement~~ Permit with site plan valid for sixty months. Authorization to Construct is valid for a period equal to that of Improvement Permit – not to exceed sixty months.

Signed: date 8-3-04 Installed by: LEATHERMAN SEPTIC TANK

Improvement Permit by: RS date 7/16/04 Operation Permit by: date 10/25/05

Authorization to Construct by: RS date 3/31/05 Existing System Inspection by: date

HEALTH DEPT. COPY: WHITE OWNER COPY (FINAL): YELLOW OWNER COPY (INITIAL): PINK