130

IREDELL COUNTY HEALTH DEPARTMENT

STATESVILLE 704-878-5305 MOORESVILLE 704-664-5281

IMPROVEMENT PERMIT / AUTHORIZATION TO CONSTRUCT / OPERATION PERMIT / EXISTING SYSTEM INSPECTION

PERMIT# 119530 PIN# ~~4637166015.000~~ 4637-05-8720 DATE 7/15/04

OWNER OR CONTRACTOR McCRARY PARTNERS, LLC / ANAITEM IT HOMES PHONE: Business 799-9770 Home

ADDRESS PO BOX 3608 MOORESVILLE NC 28117

LOCATION 150 WEST - TL McCRARY - TR RIVERWOOD - ON RT

SUBDIVISION McCRARY WOODS BLOCK / SECTION 1 LOT 8 LOT AREA .64AC SITE CLASS. PS DESIGN FLOW 480GPD L.T.A.R. .36PD/EU

Septic Tank: 1000 Gallons; STB 1012 Date 3/8/05
Pump Tank: ____ Gallons; PT ____ Date ____
Pump Make: ____ Model ____ Serial No. ____
Nitrification Field: No Fields 1 Square Feet 1200 Linear Feet 400
No Lines 5@80' Trench Width 36" Max Trench Bottom Depth 36" Gravel Depth N/A

☑ New System ☐ Repair System Type: I, II, (III), IV, V, VI
System Description: GRAVITY 25% REDUCTION
Repair System Description: LP PANEL
Maintenance Agreement Required: ☐ Yes ☑ No


☑ House/Mod. Home No. Bedrooms 4
☐ Mobile Home No. Bathrooms 4
☐ Business No. Employees ____
☐ Other ____
☐ Slab ☑ Crawl Space ☐ Basement w/plumbing ☐ Basement wo/plumbing

Water Supply: ☑ Individual ☐ Public ☐ Community


Comments:/Conditions:

Comments:/Conditions:

INITIAL SITE SKETCH 1"=50'

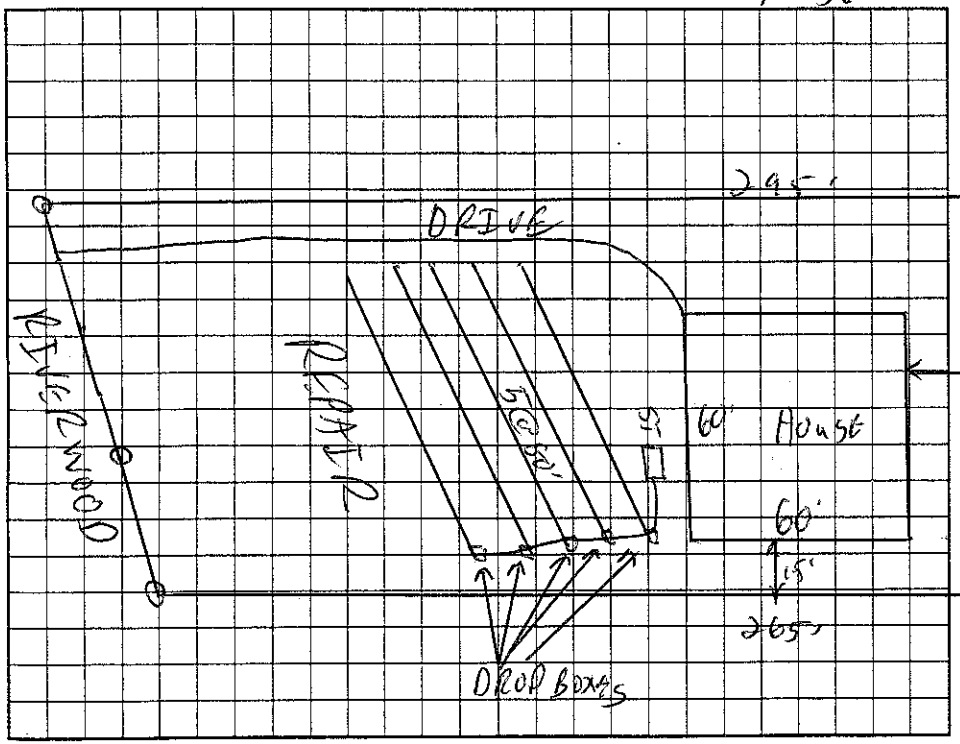

AS BUILT SKETCH

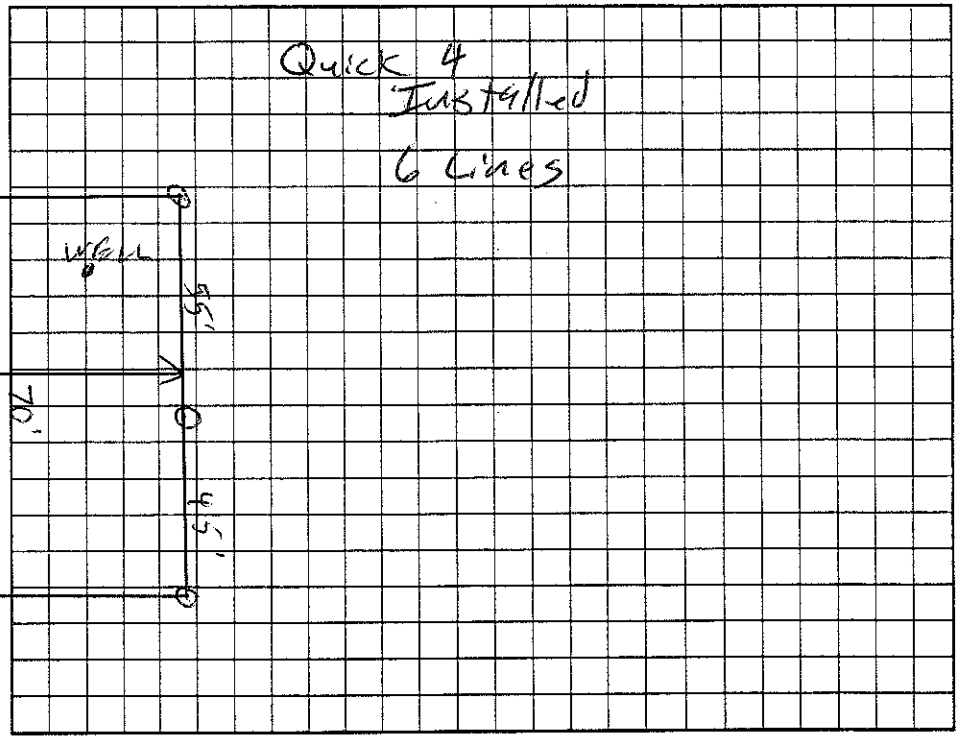

Permit can be suspended or revoked if any false information is supplied toward securing the permit/any unauthorized changes are made to the site/any unauthorized changes are made in the installation of the system. Improvement Permit with plat valid without expiration. Improvement Permit with site plan valid for sixty months. Authorization to Construct is valid for a period equal to that of Improvement Permit – not to exceed sixty months.

Signed: ____ date 8-3-04 Installed by: C+S

Improvement Permit by: C. [illegible] RS date 7/15/04 Operation Permit by: [illegible] RS date 9/29/05

Authorization to Construct by: [illegible] RS date 4/22/05 Existing System Inspection by: ____ date ____

HEALTH DEPT. COPY: WHITE OWNER COPY (FINAL): YELLOW OWNER COPY (INITIAL): PINK