IREDELL COUNTY HEALTH DEPARTMENT

STATESVILLE 704-878-5305 MOORESVILLE 704-664-5281

IMPROVEMENT PERMIT / CERTIFICATE OF COMPLETION / OPERATION PERMIT / EXISTING SYSTEM INSPECTION

PROPERTY DESCRIPTION NO. 16880 DATE sept. 30, 1993 4637-06-0798 TAX MAP NO. 2N-A-20

OWNER OR CONTRACTOR Tom Wilson Real Dev. (MARK HARPER BUILDERS) PHONE: Business 704-663-5115 Home

ADDRESS rt 4 box 11 Mooresville NC 28115

LOCATION on west side of ridge top road ; from I-77 about 3 mi. west on s/s of hwy 150

SUBDIVISION Spring Acres BLOCK / SECTION III LOT ~~58~~ 59 LOT AREA 0.5ac SITE CLASS. P L.T.A.R. 0.3

DEVELOPER READY TO ISSUE

Water Supply: ☒ Individual ☐ Community ☐ Public

Septic Tank: 1000 Gallons; STB 756 Date 4/18/95

Pump Tank: na 1000 Gallons; PT 32 Date 4/18/95

Nitrification Field: No Fields 1 Square Feet 1200 Linear Feet 400

No Lines 6 Trench Width 36" Trench Depth 24" Gravel Depth 12"

☒ New System ☐ Repair System Type: I, II, IV, V, VI

System Description: ~~gravity conventional~~

Repair System Description: ~~xxxxxxxxxxxx~~ pressure

Maintenance Agreement Required: ☐ Yes ☒ No PPBPS

☒ House/Mod. Home ☐ Mobile Home ☐ Business ☐ Other

No. Bedrooms 3 No. Bathrooms 2 No. Employees

☐ Slab ☒ Crawl Space ☐ Basement w/plumbing ☐ Basement wo/plumbing

Garbage Disposal: ☐ Yes ☒ No

Auto. Dishwasher: ☒ Yes ☐ No

Auto. Washing Machine: ☒ Yes ☐ No


Other

Comments do not install during wet soil conditions or rain. additional instructions may made upon reissuance. septic tank and pump station installed per NCAC 15A 18A .1952.

2 cyl - N98-A, # 021470

INITIAL SITE SKETCH

1" = 50'

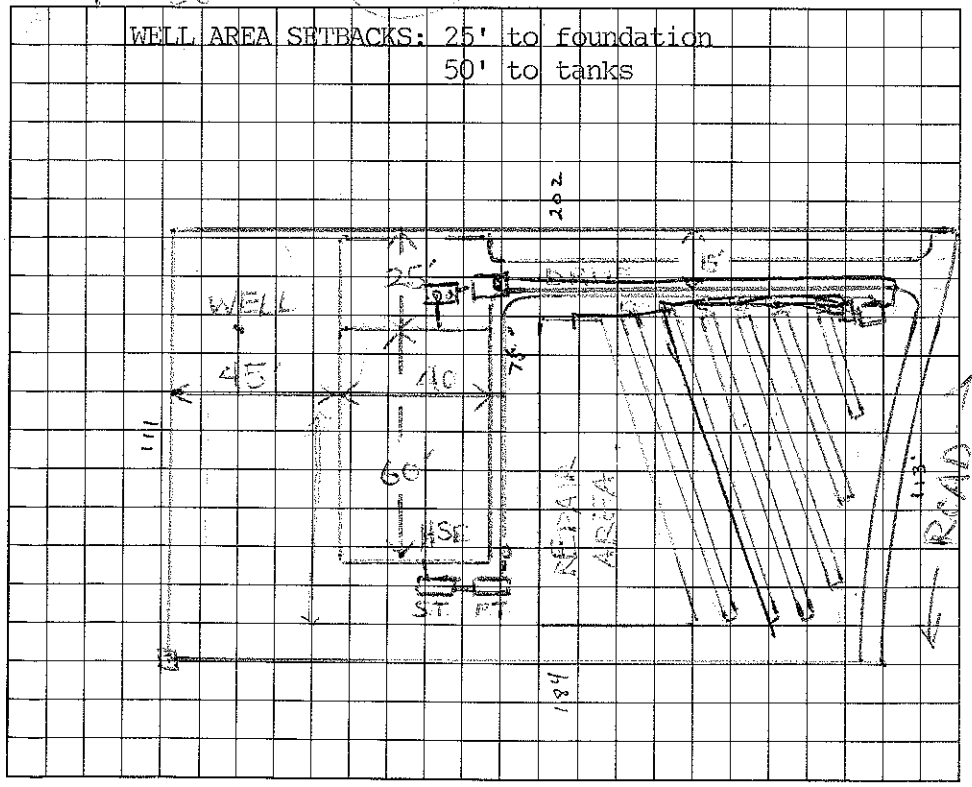

AS BUILT SKETCH

I understand that this permit can be suspended or revoked if any false information is supplied toward securing the permit/any unauthorized changes are made to the site/any unauthorized changes are made in the installation of the system. Improvement Permit is valid for 60 months from date of issuance.

Signed: Wanda Young Wesley Sparks 4/7/95

Improvement Permit by: date

Existing System Inspection by: date

Installed by: Kennedy Grading

Certificate of Completion by: Wesley Sparks RS date 12/5/95

Operation Permit by: Wesley Sparks RS. date 12/5/95

HEALTH DEPT. COPY: WHITE INSPECTION COPY (FINAL): GREEN OWNER COPY (FINAL): YELLOW INSPECTION COPY (INITIAL): PINK OWNER COPY (INITIAL): GOLD