4037061576

IREDELL COUNTY HEALTH DEPARTMENT

STATESVILLE 704-878-5305 MOORESVILLE 704-664-5281

IMPROVEMENT PERMIT / CERTIFICATE OF COMPLETION / OPERATION PERMIT / EXISTING SYSTEM INSPECTION

READY TO DEVELOPER PICK UP PERMIT ISSUE

PROPERTY DESCRIPTION NO. 16882 DATE sept. 30, 1993 TAX MAP NO. 2N-A-20

OWNER OR CONTRACTOR Tom Wilson Real Dev. (Jim Lemer) PHONE: Business 704-663-5115 Home

ADDRESS rt4 box 11 Mooresville, NC 28115

LOCATION ~~On west side of ridge top road; from I-77 about 3 mi. west on s/s of hwy 150~~ L TO END OF RIDGE TOP.

SUBDIVISION Spring Acres BLOCK / SECTION III LOT ~~60~~ 57 LOT AREA 0.71 ac SITE CLASS. P L.T.A.R. 0.3

Water Supply: ☒ Individual ☐ Community ☐ Public

Septic Tank: 1000 Gallons; STB 794 Date 5/13/95

Pump Tank: na Gallons; PT Date

Nitrification Field: No Fields 1 Square Feet 1200 Linear Feet 400

No Lines ~~X~~ 3 Trench Width 36" Trench Depth 24" Gravel Depth 12"

☒ New System ☐ Repair System Type: I (II) II, IV, V, VI

System Description: gravity conventional

Repair System Description: grav conv

Maintenance Agreement Required: ☐ Yes ☒ No

☒ House/Mod. Home No. Bedrooms 3

☐ Mobile Home No. Bathrooms 2

☐ Business No. Employees

☐ Other

Garbage Disposal: ☐ Yes ☒ No

Auto. Dishwasher: ☒ Yes ☐ No

Auto. Washing Machine: ☒ Yes ☐ No


Other

☐ Slab ☒ Crawl Space ☐ Basement w/plumbing ☐ Basement wo/plumbing

Comments do not install during wet soil conditions or rain. additional instructions may be made upon reissuance.

Ready to issue 10/14/94 AWS

INITIAL SITE SKETCH

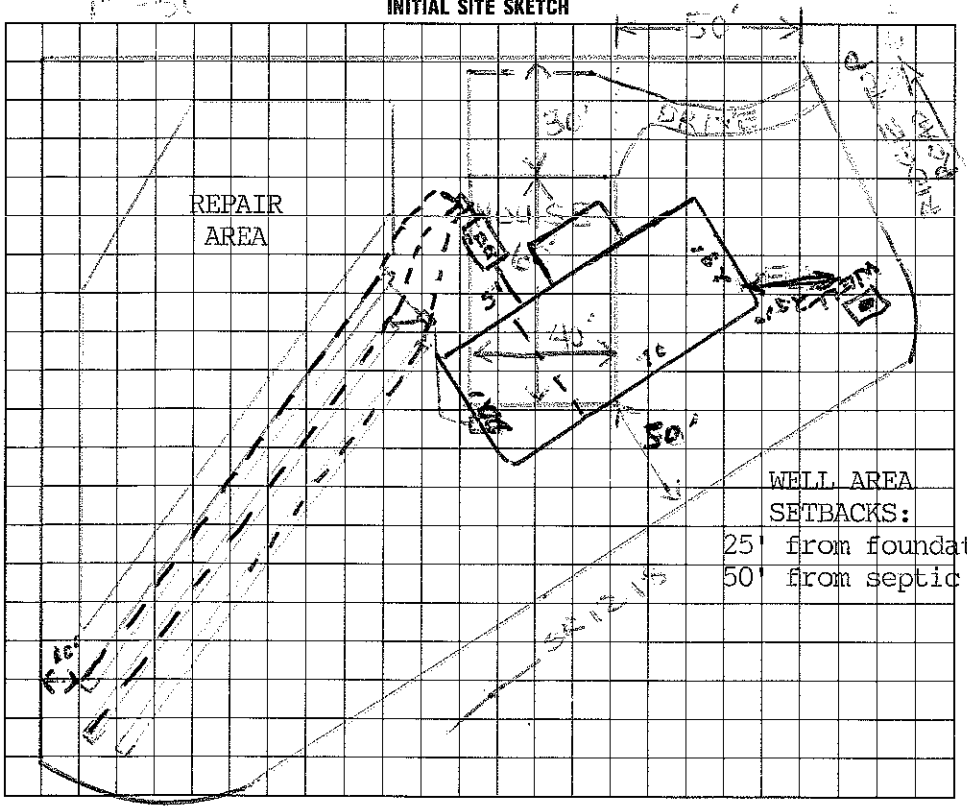

AS BUILT SKETCH

Installed 300 feet of diversion.

I understand that this permit can be suspended or revoked if any false information is supplied toward securing the permit/any unauthorized changes are made to the site/any unauthorized changes are made in the installation of the system. Improvement Permit is valid for 60 months from date of issuance.

Signed: Wanda Young Jenkins 10/14/94

Improvement Permit by: [illegible] date 8-7-93

Existing System Inspection by: date

Installed by: Richard Abernathy

Certificate of Completion by: Wesley Sparks RS. date 4/21/95

Operation Permit by: date

HEALTH DEPT. COPY: WHITE INSPECTION COPY (FINAL): GREEN OWNER COPY (FINAL): YELLOW INSPECTION COPY (INITIAL): PINK OWNER COPY (INITIAL): GOLD