IREDELL COUNTY HEALTH DEPARTMENT

STATESVILLE 704-878-5305 MOORESVILLE 704-664-5281

IMPROVEMENT PERMIT / AUTHORIZATION TO CONSTRUCT / OPERATION PERMIT / EXISTING SYSTEM INSPECTION

PERMIT# 16884 PIN# 2N A 20 4637 06 3878 DATE 6/23/98

OWNER OR CONTRACTOR Ken Teeter PHONE: Business 313-451-0706 Home

ADDRESS 1438 Chesterfield Dr. Canton Ohio 48187

LOCATION Top of Ridge Rd. 150' W Jct Spring Acres Lane (R) Top of Ridge on (L) just before SR 1218

SUBDIVISION Spring Acres BLOCK / SECTION III LOT 55 LOT AREA ~1.96AC SITE CLASS. PS DESIGN FLOW 480 L.T.A.R. .3

Septic Tank: 1000 Gallons; STB 760 Date 6/26/98

Pump Tank: 1000 Gallons; PT Date 6/14/98

Pump Make: #90 ROMATIC Model SHEF50A Serial No. 6/98

Nitrification Field: No Fields 1 Square Feet 1200* Linear Feet 400*

No Lines *4 Trench Width 36" Max Trench Bottom Depth 36" Gravel Depth SAND.

[X] New System [ ] Repair System Type: I, II, (III) IV, V, VI

System Description: PacMan-Ch Plastic

Repair System Description: Same

Maintenance Agreement Required: [ ] Yes [X] No

[X] House/Mod. Home No. Bedrooms 4

[ ] Mobile Home No. Bathrooms 3

[ ] Business No. Employees

[ ] Other


[ ] Slab [ ] Crawl Space [X] Basement w/plumbing [ ] Basement wo/plumbing

Water Supply: [X] Individual [ ] Public [ ] Community


Comments:/Conditions: *25% reduction for Chamber Plastic Drainfield

Comments:/Conditions:

INITIAL SITE SKETCH

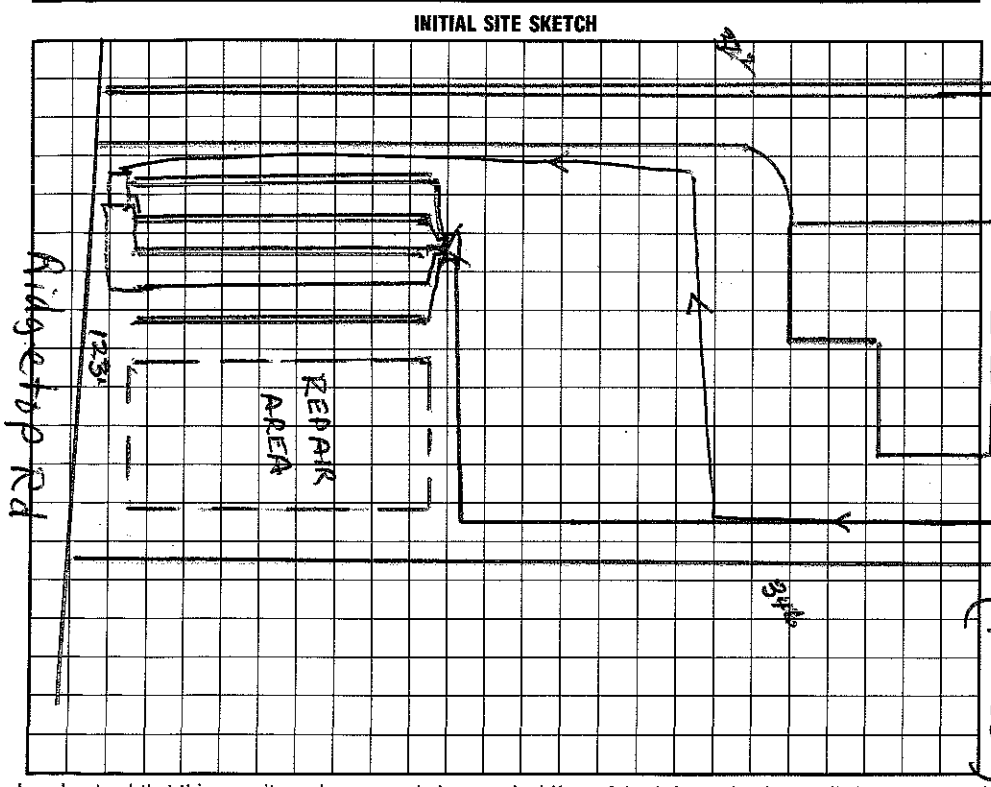

AS BUILT SKETCH

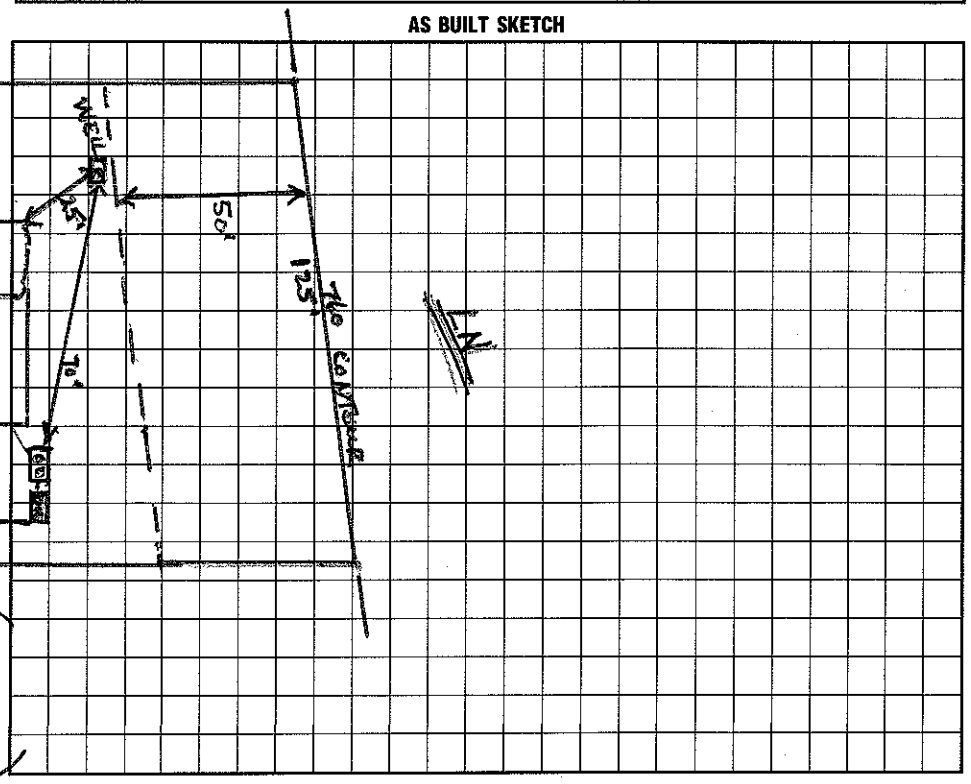

I understand that this permit can be suspended or revoked if any false information is supplied toward securing the permit/any unauthorized changes are made to the site/any unauthorized changes are made in the installation of the system. Improvement Permit with plat valid without expiration. Improvement Permit with site plan valid for sixty months. Authorization to Construct is valid for a period equal to that of Improvement Permit – not to exceed sixty months.

Signed: * date 6/29/98 Installed by: William Fortner Blake

Improvement Permit by: Wesley Sparks RS. date 6/23/98 Operation Permit by: Wesley Sparks RS. date 9/25/98

Authorization to Construct by: Wesley Sparks RS. date 6/23/98 Existing System Inspection by: date

HEALTH DEPT. COPY: WHITE INSPECTION COPY (FINAL): GREEN OWNER COPY (FINAL): YELLOW INSPECTION COPY (INITIAL): PINK OWNER COPY (INITIAL): GOLD